

NE SHOBA

N 2006

MISSISSIPPI
BOARD OF WATER COMMISSIONERS
416 North State Street
Jackson, Mississippi 39201

WATER WELL DRILLERS LOG

Dec. 19 28 Thomas Row Neshoba
date well completed firm name county well located

LANDOWNER: Ruel Hatley

Phila. Miss.

(mailing address)

description of formations encountered

from to

D.T.
CHALKY SAND 0 20
CHALK 20 40
SAND 40 52
52 65

WELL LOCATION:

sec. 3 T 9 N R 10 E
S W
2 miles SW of DIXON
(distance) (direction) (nearest town)

WELL PURPOSE:

(home, irrigation, municipal, industrial)

WELL COMPLETION DATA:

- (1) diameter (inches) 2
- (2) total depth (feet) 65
- (3) static water level (feet) 30 ^{below} _{above} top of ground.
- (4) casing pc 60
(material) (depth)
2 (size) if telescope see back.
- (5) screen 5 60
(length) (depth to top)
2" slot pc
(size) (material)
- (6) pump 1/2 6
(HP) (yield gpm)
2 sec
(type power)
- (7) electric log NO
(yes or no)

(organization running log)

(8) how well bottom plugged loint


DRILLERS REMARKS:

RECEIVED
JAN 3 1978

MISS. BD. OF WATER COMM

If well telescopes please sketch and show depths.

GROUND LEVEL

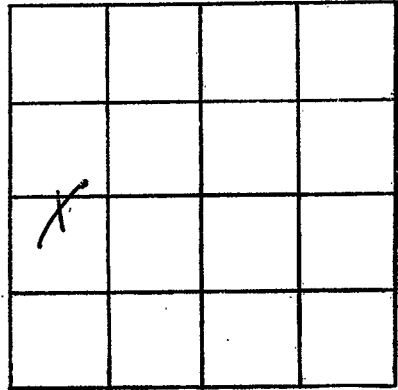

SECTION 3

Please indicate well location X.

ADDITIONAL INFORMATION

If more than one screen, show locations of each on sketch.