

Neshoba
N 2007

MISSISSIPPI
BOARD OF WATER COMMISSIONERS
416 North State Street
Jackson, Mississippi 39201

WATER WELL DRILLERS LOG

4-4-80

4-4 1980

Thomas C. Car

Neshoba

date well completed

firm name

county well located

LANDOWNER: John Carter
Rt 9
Philadelphia, MS.
(mailing address)

description of formations encountered	from	to
Red Clay	0	10
Red Sand	10	25
Dry Sand	25	35
SAND REAL Course	55	83

WELL LOCATION:
sec. 10 T 9 N R 10 E
S W
10 miles SW of Phila.
(distance) (direction) (nearest town)

WELL PURPOSE:
(home, irrigation, municipal, industrial)

- WELL COMPLETION DATA:
- (1) diameter (inches) 2
 - (2) total depth (feet) 83
 - (3) static water level (feet) 55 ^{below} _{above} top of ground
 - (4) casing PVC, 78 (material) (depth)
2 (size) if telescope see back.
 - (5) screen 5, 79 (length) (depth to top)
2, 83 let PVC (size) (material)
 - (6) pump 1, 8 (HP) (yield gpm)
Elae (type power)
 - (7) electric log No (yes or no)
(organization running log)
 - (8) how well bottom plugged *ferret*

DEPT. OF NATURAL RESOURCES
BUREAU OF LAND & WATER RESOURCES


APR 21 1980

RECEIVED

DRILLERS REMARKS:

If well telescopes please sketch and show depths.

GROUND LEVEL

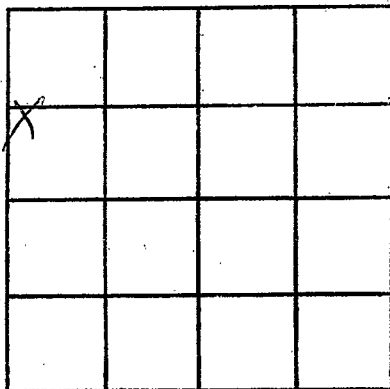

SECTION 10

Please indicate well location X.

ADDITIONAL INFORMATION

If more than one screen, show locations of each on sketch.