

Neshoba

N 2008

7-9-80

7-9 1980 date well completed

MISSISSIPPI BOARD OF WATER COMMISSIONERS 416 North State Street Jackson, Mississippi 39201

WATER WELL DRILLERS LOG

Thomas & Son firm name

Neshoba county well located

LANDOWNER: Bonnie R. White

description of formations encountered	from	to
Red CLAY	0	15
Dry SAND	15	50
Course SAND	50	80

Phila, Ms.

(mailing address)

WELL LOCATION:

sec. 5 T 9N R 10E S W Phila. 10 miles SW of Phila. (distance) (direction) (nearest town)

WELL PURPOSE:

(home, irrigation, municipal, industrial)

WELL COMPLETION DATA:

- (1) diameter (inches) 2" 80 FT
- (2) total depth (feet) 80
- (3) static water level (feet) 50 (below above top of ground)
- (4) casing PVC 75 (material) (depth) 2 (size) if telescope see back.
- (5) screen 5 75 (length) (depth to top) 2" 10 slot PVC (size) (material)
- (6) pump 8 Ebe (HP) (yield gpm) Ebe (type power)
- (7) electric log No. (yes or no)

(organization running log)

(8) how well bottom plugged Low

DEPT. OF NATURAL RESOURCES BUREAU OF LAND & WATER RESOURCES


JUL 16 1980

RECEIVED

DRILLERS REMARKS:

If well telescopes please sketch and show depths.

GROUND LEVEL

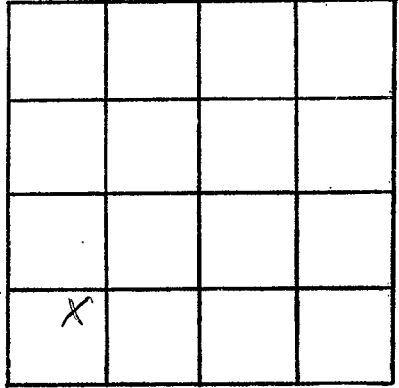

SECTION 5

Please indicate well location X.

ADDITIONAL INFORMATION

If more than one screen,
show locations of each on sketch.