

NESHOBAMA  
N 2009  
2-17-81

MISSISSIPPI  
 BOARD OF WATER COMMISSIONERS  
 416 North State Street  
 Jackson, Mississippi 39201

WATER WELL DRILLERS LOG

2-17 19 81 Thomas Neshoba  
 date well completed firm name county well located

LANDOWNER: Ollie Brazell  
Rt 9  
Phila. Miss  
 (mailing address)

description of formations encountered	from	to
Red CLAY	0	10
Red SAND	10	30
DRY "	30	85
SAND	85	120

WELL LOCATION:  
 sec. 18 T. 9 N R. 10 E  
9 miles SW of Phila  
 (distance) (direction) (nearest town)

WELL PURPOSE:  
 (home, irrigation, municipal, industrial)

- WELL COMPLETION DATA:
- (1) diameter (inches) 2
  - (2) total depth (feet) 123
  - (3) static water level (feet) 85 below above top of ground.
  - (4) casing PV 113  
 (material) (depth)  
2 if telescope see back.  
 (size)
  - (5) screen 113 10 ft  
 (length) (depth to top)  
2" 10 slot PVC  
 (size) (material)
  - (6) pump 1 6  
 (HP) (yield gpm)  
Elec  
 (type power)
  - (7) electric log no  
 (yes or no)
- (organization running log)

(8) how well bottom plugged POINT


DRILLERS REMARKS:

DEPT. OF NATURAL RESOURCES  
 BUREAU OF LAND & WATER RESOURCES

APR 16 1981  
 RECEIVED

If well telescopes please sketch and show depths.

GROUND LEVEL

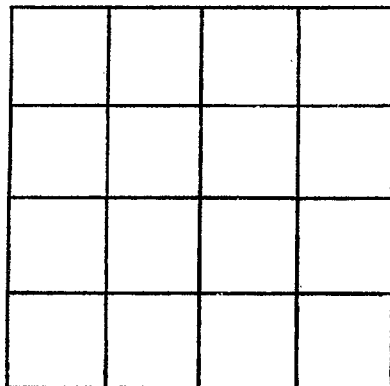

SECTION \_\_\_\_\_

Please indicate well location X.

ADDITIONAL INFORMATION

If more than one screen, show locations of each on sketch.