

Neshoba  
N 210  
7-15-81

MISSISSIPPI  
BOARD OF WATER COMMISSIONERS  
416 North State Street  
Jackson, Mississippi 39201

WATER WELL DRILLERS LOG

7-15-81 date well completed  
THOMAS firm name  
Neshoba county well located

LANDOWNER: Billy McBeth  
Sepostafall  
(mailing address)

WELL LOCATION:  
sec. 29 T. 9 N. R. 10 E  
11 miles SW of Phila.  
(distance) (direction) (nearest town)

WELL PURPOSE:  
(home, irrigation, municipal, industrial)

- WELL COMPLETION DATA:
- (1) diameter (inches) 2
  - (2) total depth (feet) 223
  - (3) static water level (feet) 55 below top of ground.
  - (4) casing PVC, 170 (material) (depth)  
2 (size) if telescope see back.
  - (5) screen OPEN (length) (depth to top)  
(size) (material)
  - (6) pump 1 (HP) 6 (yield gpm)  
elec (type power)
  - (7) electric log NO (yes or no)  
(organization running log)
  - (8) how well bottom plugged open

description of formations encountered	from	to
Dirt	0	15
Grey CHALK	15	22
Lignite	22	26
Black Chalking SAND	26	70
Dirt SAND	70	85
Little ROCK	85	106
BLACK DIRT	106	
Rock + shell	168	196
GREEN SAND	196	223

DRILLERS REMARKS:


DEPT. OF NATURAL RESOURCES  
BUREAU OF LAND & WATER RESOURCES

OCT - 9 1981

RECEIVED

If well telescopes please sketch and show depths.

GROUND LEVEL

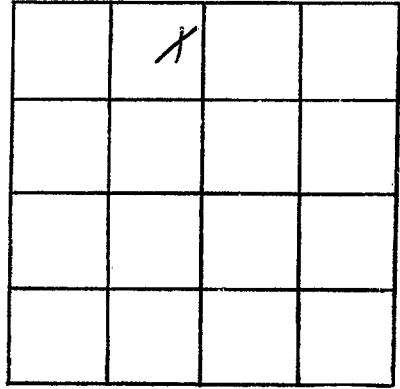

SECTION 29

Please indicate well location X.

ADDITIONAL INFORMATION

If more than one screen,  
show locations of each on sketch.