

Neshoba  
N  
2011

MISSISSIPPI  
BOARD OF WATER COMMISSIONERS  
416 North State Street  
Jackson, Mississippi 39201

WATER WELL DRILLERS LOG

3-R 1982 date well completed      THOMAS firm name      Neshoba county well located

LANDOWNER: SANDY McBeth  
R+1  
UNION MS  
(mailing address)

WELL LOCATION:  
sec. 17 T. 9 N R. 10 E  
3 miles SW of DIXON  
(distance) (direction) (nearest town)

WELL PURPOSE:  
(home, irrigation, municipal, industrial)

WELL COMPLETION DATA:  
(1) diameter (inches) 2  
(2) total depth (feet) 203  
(3) static water level (feet) 36 below top of ground.  
(4) casing PVC 140 (material) (depth)  
2 (size) if telescope see back.  
(5) screen Open (length) (depth to top)  
(size) (material)  
(6) pump 3/4 (HP) 6 (yield gpm)  
Elec. (type power)  
(7) electric log NO (yes or no)  
(organization running log)  
(8) how well bottom plugged Open

description of formations encountered	from	to
Pipe clay	0	15
BLACK DIRT	15	22
SAND. COURSE AT BOTTOM	22	71
BLACK DIRT	71	149
Rock + Shell	149	180
GREEN-SAND	180	203

DRILLERS REMARKS:


DEPT. OF NATURAL RESOURCES  
BUREAU OF LAND & WATER RESOURCES

APR 2 1982

RECEIVED

If well telescopes please sketch and show depths.

GROUND LEVEL

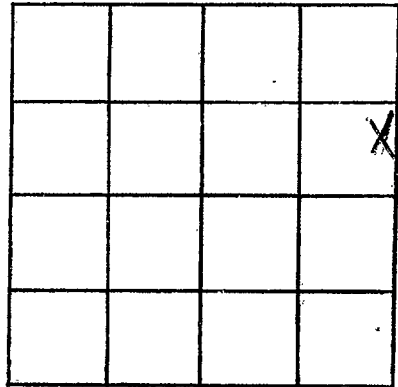

SECTION 17

Please indicate well location X.

ADDITIONAL INFORMATION

A series of horizontal lines for writing additional information.

If more than one screen, show locations of each on sketch.