

**MISSISSIPPI DEPARTMENT OF NATURAL RESOURCES**  
**Bureau of Land and Water Resources**  
 Southport Mall  
 P.O. Box 10631  
 Jackson, Mississippi 39209  
**WATER WELL DRILLERS LOG**

Neshoba  
N  
2012

6-8 1983 Thomas + son Neshoba  
 date well completed firm name county well located

LANDOWNER: Carolina Presby Church description of formations encountered from to  
Phila miss Red Dirt 0 6  
 (mailing address) Red Sand 6 34  
Coarse White sand 34 55

WELL LOCATION:  
 sec. 18 T 9 N R 10 E  
2 miles (distance) SW (direction) of Douville (nearest town)

Deep (55)

WELL PURPOSE:  
 (home, irrigation, municipal, industrial)

- WELL COMPLETION DATA:
- (1) diameter (inches) 2"
- (2) total depth (feet) 55'
- (3) static water level (feet) 28' below above top of ground.
- (4) casing PVC, 55' (material) (depth)  
2" (size) if telescope see back.
- (5) screen 10', 45' (length) (depth to top)  
2" (size) PVC (material)
- (6) pump 1, 10 (HP) (yield gpm)  
Electric (type power)
- (7) electric log no (yes or no)  
 (organization running log)
- (8) how well bottom plugged Screen

DRILLERS REMARKS:


MISSISSIPPI DEPARTMENT OF NATURAL RESOURCES  
 BUREAU OF LAND & WATER RESOURCES

**AUG 24 1983**

**RECEIVED**

If well telescopes please sketch and show depths.

GROUND LEVEL

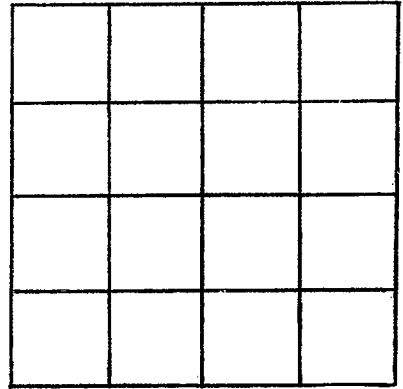

SECTION \_\_\_\_\_

Please indicate well location X.

ADDITIONAL INFORMATION

If more than one screen,  
show locations of each on sketch.