

MISSISSIPPI DEPARTMENT OF NATURAL RESOURCES

Bureau of Land and Water Resources

Southport Mall

P.O. Box 10631

Jackson, Mississippi 39209

WATER WELL DRILLERS LOG

NESHORA
N 2013

7-2-1984 date well completed
F.O. Pomors firm name
NESHORA county well located

LANDOWNER: Yorkville

(mailing address)

WELL LOCATION:
sec. 20 9 N 10 E
1 miles N of Dowdville
(distance) (direction) (nearest town)

WELL PURPOSE:
(home, irrigation, municipal, industrial)

WELL COMPLETION DATA:

(1) diameter (inches) 2"

(2) total depth (feet) 149'

(3) static water level (feet) 80 below top of ground.

(4) casing 2" 149'
(material) (depth)

2" if telescope see back.
(size)

(5) screen 2" 149'
(length) (depth to top)

2 1/4 Steel
(size) (material)

(6) pump 1 220
(HP) (yield gpm)

Elec.
(type power)

(7) electric log NO
(yes or no)

open
(organization running log)

(8) how well bottom plugged _____

DRILLERS REMARKS: _____


description of formations encountered	from	to
<u>Red clay</u>	<u>0</u>	<u>40</u>
<u>Black siltstone</u>	<u>125</u>	<u>125</u>
<u>Shell and sand</u>	<u>130</u>	<u>130</u>
<u>Green sand</u>	<u>130</u>	<u>149'</u>

DEPT. OF NATURAL RESOURCES
BUREAU OF LAND & WATER RESOURCES

JUL 10 1984
RECEIVED

If well telescopes please
sketch and show depths.

GROUND LEVEL

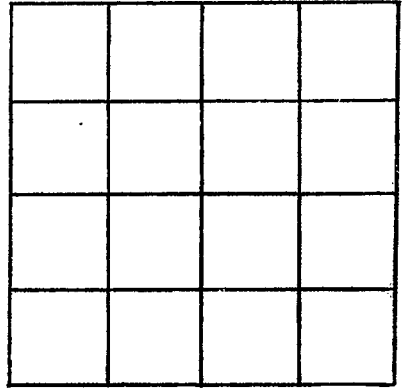

SECTION _____

Please indicate well location X.

ADDITIONAL INFORMATION

If more than one screen,
show locations of each on sketch.