

MISSISSIPPI DEPARTMENT OF NATURAL RESOURCES

Bureau of Land and Water Resources

P.O. Box 10631

Jackson, Mississippi 39209

WATER WELL DRILLERS LOG

COUNTY WELL LOCATED  
**Neshoba**

WELL NUMBER CODED  
**N 2016**

DATE WELL COMPLETED  
**2-4-91**

PERMIT NUMBER

NAME OF DRILLING FIRM  
**Gardner Drilling**

**Sebastopol, MS**

NAME & MAILING ADDRESS OF LANDOWNER  
**Jimmie Buntarr**

**Rt. 2 Box 437**

**Union, MS 39365**

WELL LOCATION: SEC **35** TOWNSHIP **9** RANGE **N 10 E**

DISTANCE **8** Miles DIRECTION **W** of NEAREST TOWN **Union**

OTHER LANDMARK

WELL PURPOSE: Home, Irrigation, Municipal, Industrial, Fish Pond, etc.  
**Poultry Farm**

PUMP DATA

PUMP TYPE (Circle One):  
Submersible, Turbine, **Jet** Flowing Well,  
Other (Describe) \_\_\_\_\_

POWER TYPE (Circle One):  
**Electric** Tractor, Diesel, Gasoline, Butane,  
Other (Describe) \_\_\_\_\_ H/P \_\_\_\_\_

Pump Capacity (GPM) \_\_\_\_\_ No. of Stages \_\_\_\_\_ Setting Depth \_\_\_\_\_ FT.

PUMP TEST

Well yielded **15** GPM with  
a drawdown of **11** ft.  
after **2** hours of pumping

WELL DATA

Well Depth <b>165</b>	Casing Diameter (in.) <b>2</b>	Casing Length (ft.) <b>165</b>
Type of Casing <b>PVC</b>	Hole Depth <b>165</b>	Depth to Static Water Level <b>19</b>

TYPE OF COMPLETION: (Circle One or More):  
**Gravel Packed**, Underreamed, Telescoped,  
Natural Development, Open Hole, Other

Top of Lap Pipe or Reduction in Casing

FEET IF TELESCOPED OR MORE THAN ONE SCREEN: USE BACK PAGE

LOG DATA

TYPE OF LOG RUN (Circle One): No Log Run,  
Electric, Gamma Ray, Density, Sonic, Neutron,  
Other (Describe) \_\_\_\_\_

Name of Organization Running Log

SCREEN DATA

Diameter - Inches <b>#2</b>	Length - Feet <b>5</b>	Slot Size - Inches <b>10</b>
Screen Type <b>PVC Rib</b>	Depth to Bottom - Feet <b>165</b>	

GEOLOGIC DATA (Office Use Only)

Surface Elev.	Geologic Unit	Unit Thickness	Depth to Top
Subs. SWL	Date	Analysis	Aquifer Test

Driller's Remarks


DESCRIPTION OF FORMATIONS ENCOUNTERED	FROM	TO	FORMATIONS (Continued)	FROM	TO
Clay	0	15	<b>RECEIVED</b>		
Sand	15	37			
Clay	37	48			
Rock	48	51			
Clay	51	117			
Sand	117	165	<b>FEB 15 1991</b>		

Dept. of Environmental Quality  
Bureau of Land & Water Resources

IF MORE SPACE IS NEEDED, USE BACK

If well telescopes please sketch and show depths.

GROUND LEVEL

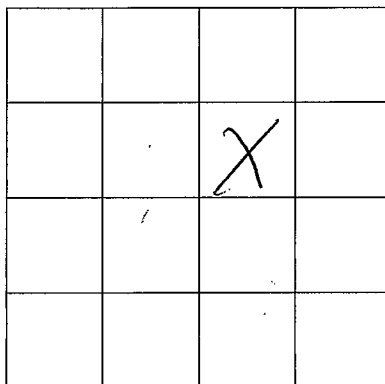

SECTION 35

Please indicate well location X.

ADDITIONAL INFORMATION

If more than one screen, show location of each on sketch.