

5 13T

MISSISSIPPI
BOARD OF WATER COMMISSIONERS
416 North State Street
Jackson, Mississippi 39201

WATER WELL DRILLERS LOG

NEKHOBA

Ø 2

3-68

3-28

CODED

1968

R R Johnson

Neshoba

date well completed

firm name

county well located

LANDOWNER:

John Barber

description of formations encountered

from to

dirt & sand

0' 23'

blue dirt

23' 115'

water sand

115' 140'

Shila Miss.
(mailing address)

WELL LOCATION:

sec. 29 T. 9 N R. 11 E
S W

6 1/2 miles west of Union
(distance) (direction) (nearest town)

WELL PURPOSE:

home
(home, irrigation, municipal, industrial)

WELL COMPLETION DATA:

CODED

- (1) diameter (inches) 2"
- (2) total depth (feet) 140'
- (3) static water level (feet) 47 below above top of ground.

- (4) casing 2" (material), 96' (depth), 7" (size) if telescope see back.

- (5) screen (length) (depth to top) (size) (material)

- (6) pump 1/2 (HP), 7 1/2 (yield GPM) (type power)

- (7) electric log (yes or no)

(organization running log)

- (8) how well bottom plugged

DRILLERS REMARKS:

Good


MAY 14 1968

MISS. Bd. of WATER COMMISSIONERS



If well telescopes please sketch and show depths.

GROUND LEVEL

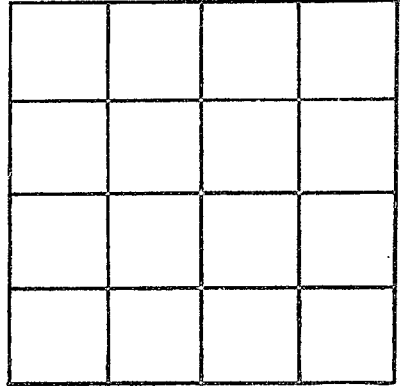

SECTION _____

Please indicate well location X.

ADDITIONAL INFORMATION

If more than one screen, show locations of each on sketch.