

5 13T

MISSISSIPPI
BOARD OF WATER COMMISSIONERS
416 North State Street
Jackson, Mississippi 39201

CWATER WELL DRILLERS LOG

Neshoba
03
1-68

Jan. 4 1968 R.B. Nicholson Neshoba
 Date well completed firm name county well located

LANDOWNER: Charlie S. Hogan

description of formations encountered	from	to
<u>Clay & sand</u>	<u>0</u>	<u>18</u>
<u>Chalk & sand</u>	<u>18</u>	<u>36</u>
<u>Water sand</u>	<u>36</u>	<u>48</u>

RT 1
Union Miss.
 (mailing address)

WELL LOCATION:
 sec 35 T 9 N R 10 E
3 1/2 miles west of Union
 (distance) (direction) (nearest town)


WELL PURPOSE: home
 (home, irrigation, municipal, industrial)

WELL COMPLETION DATA:

- (1) diameter (inches) 4"
- (2) total depth (feet) 48 ft
- (3) static water level (feet) 36" below top of ground.
- (4) casing cast 43"
 (material) (depth)
- 2" if telescope see back.
 (size)
- (5) screen 5' 48"
 (length) (depth to top)
- 1/4"
 (size) (material)
- (6) pump 1/2 5
 (HP) (yield gpm)
- Elect
 (type power)
- (7) electric log no
 (yes or no)
- (organization running log)
- (8) how well bottom plugged

CODER


MAY 14 1968

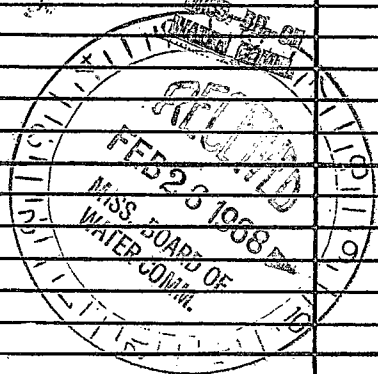

DRILLERS REMARKS:

If well telescopes please sketch and show depths.

GROUND LEVEL

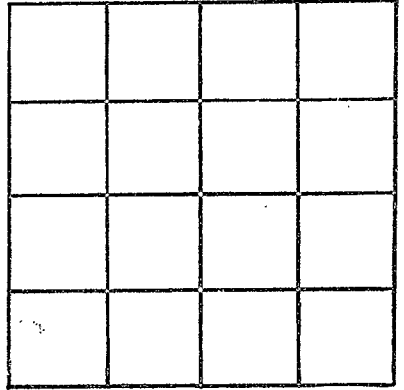

SECTION _____

Please indicate well location X.

ADDITIONAL INFORMATION

If more than one screen,
show locations of each on sketch.