

3 13T

MISSISSIPPI
BOARD OF WATER COMMISSIONERS
416 North State Street
Jackson, Mississippi 39201

WATER WELL DRILLERS LOG

Neshoba
Ø 5.
12-67
CODED

DECEMBER 27 19 67 OGLETREE DRILLING NESHOPA
date well completed firm name county well located

LANDOWNER: R.C. JONES
RT. 1 NESHOPA

description of formations encountered	from	to
RED CLAY	0	20
RED SAND	20	60
WHITE SAND	60	78

(mailing address)


WELL LOCATION:
sec. 22 T 9 N R 11 E
7 miles SOUTH PHILA.
(distance) (direction) (nearest town)

WELL PURPOSE: HOME USE
(home, irrigation, municipal, industrial)

WELL COMPLETION DATA:

- (1) diameter (inches) 2"
- (2) total depth (feet) 78'
- (3) static water level (feet) 35 below above top of ground.
- (4) casing GAV. 73
(material) (depth)
If telescope see back.
(size)
- (5) screen 45' 78-63
(length) (depth to top)
1 1/4 5 ft.
(size) (material)
- (6) pump 3/4 6.5
(HP) (yield gpm)
REA
(type power)
- (7) electric log
(yes or/no)
(organization running log)
- (8) how well bottom plugged POINTED

CODED

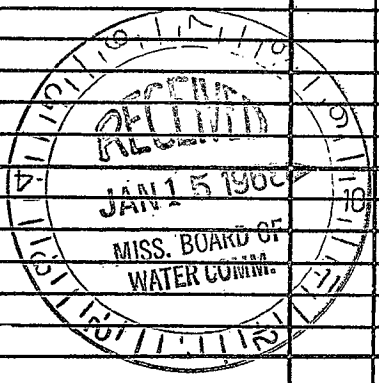

DRILLERS REMARKS:

If well telescopes please sketch and show depths.

GROUND LEVEL

X			

SECTION 22

Please indicate well location X.

ADDITIONAL INFORMATION

If more than one screen, show locations of each on sketch.