

3 135

Neshoba
Φ 6
10-67

MISSISSIPPI
BOARD OF WATER COMMISSIONERS
416 North State Street
Jackson, Mississippi 39201

CODED WATER WELL DRILLERS LOG

OCTOBER 25 19 67 OGLETREE DRILLING NESHOBA
date well completed firm name county well located

LANDOWNER: THEMLA BOLER

NESHOBA, MISS.

(mailing address)

WELL LOCATION:

sec. 14 T. 9 N R. 11 E
10 miles S of PHILA,
(distance) (direction) (nearest town)

WELL PURPOSE HOME USE
(home, irrigation, municipal, industrial)

WELL COMPLETION DATA:

- (1) diameter (inches) 2"
- (2) total depth (feet) 63
- (3) static water level (feet) 30 below above top of ground.
- (4) casing GAV. 58
(material) (depth)

(size) if telescope see back.

- (5) screen 5 63-58
(length) (depth to top)
1 1/4 STAINLESS STEEL
(size) (material)

- (6) pump 3/4 6
(HP) (yield gpm)
REA
(type power)

- (7) electric log NO
(yes or no)

(organization running log)

- (8) how well bottom plugged POINTED


DRILLERS REMARKS:

description of formations encountered

from to

RED CLAY	0	30
ROCK	30	40
WHITE SAND	40	63

CODED

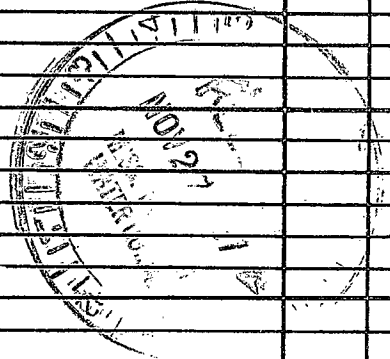

If well telescopes please sketch and show depths.

GROUND LEVEL

	X		

SECTION 14

Please indicate well location X.

ADDITIONAL INFORMATION

If more than one screen, show locations of each on sketch.