

NESHOBA

MISSISSIPPI BOARD OF WATER COMMISSIONERS

07

513T

10-12-61

CODED

WATER WELL DRILLERS LOG

Date: 10-12, 1961, Driller: M.R. Ray County: nebraska

(Name)

(1) Owner of Land: John Grinder  
(Name)  
Neshoba Miss 19#1  
(Address)

(2) Location: 1/4, 1/4, Sec. 5 9 1 T. 1 R. 1  
2 miles north of Neshoba  
(distance) (direction) (Nearest Town)

(3) Topography: V  
(Hilly) (Flat) (Level)

(4) Purpose of Well: Domestic  
(Domestic Irrigation  
Municipal, Industrial, Other)

Description & Color of Materials Sand, Clay, Red Clay, Shell, etc.	Thick- ness Feet	Depth Feet
<u>Red clay to 20 ft</u>		
<u>light blue dirt</u>		
<u>Sand to 94 ft</u>		
<u>white sand 90 ft</u>		

Information upon completion of well:

- (1) Diameter 2 inches.
- (2) Total Depth 96 feet.
- (3) Water Level 60 feet below top of ground.
- (4) Cased to 90, Size 2
- (5) Screen: Size 60, Length 6
- (6) Were any formations sealed against pollution?  
\_\_\_\_\_ yes, L no.


If YES depth of formation \_\_\_\_\_

Why \_\_\_\_\_

Drillers Remarks:

Near Linnwood school  
on H.G. 15 north  
of nebraska

CODED

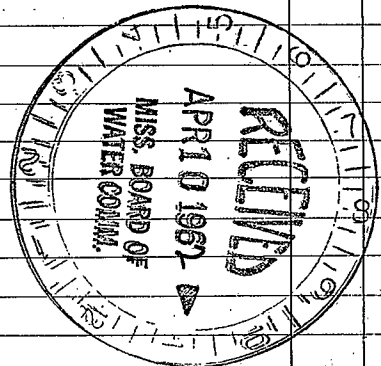

(Use Back Side)

Well No.

