

Φ 8

CODED

WATER WELL DRILLERS LOG

5 13 T

CODED

Date: 8-15, 1962

Driller: M J Ray

County: Westmore

8-15-62

(1) Owner of Land: Maanel McCraw
 (Name)
Union R #1
 (Address)

(2) Location: 1/4, 1/4, Sec. 26 T 9 R 11,
2 miles west, of Union,
 (distance) (direction) (Nearest Town)

(3) Topography: (Hilly) (Flat) (Level)

(4) Purpose of Well: Domestic
 (Domestic Irrigation
 Municipal, Industrial, Other)

Description & Color of Materials Sand, Clay, Red Clay, Shell, etc.	Thick- ness Feet	Depth Feet
<u>Yellow dirt to</u>	<u>20</u>	<u>ft</u>
<u>Dark shale rock</u>	<u>45</u>	<u>ft</u>
<u>Yellow sand</u>	<u>55</u>	<u>ft</u>
<u>white sand</u>	<u>75</u>	<u>ft</u>
<u>White sand</u>	<u>55 x 75</u>	<u>ft</u>

Information upon completion of well:

(1) Diameter 2 inches.

(2) Total Depth 75 feet.

(3) Water Level 3.5 feet below top of ground.

(4) Cased to 69, Size 2 in.

(5) Screen: Size 60 mesh Length 6 ft.


(6) Were any formations sealed against pollution?
 _____ yes, no.

If YES depth of formation _____

Why _____

Drillers Remarks: _____

CODED

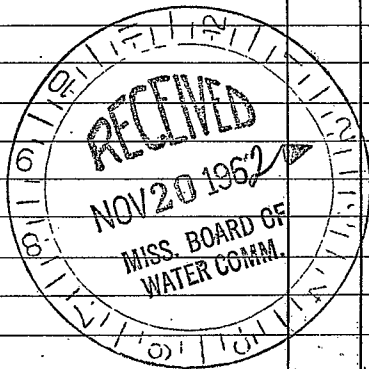

(Use Back Side)

Well No.

