

①9
4-17-61

WATER WELL DRILLERS LOG

CODED

Date: 4/17, 19 61. Driller: Hester Lightfoot County Neshoba
(Name)

	Description & Color of Materials Sand, Clay, Red Clay, Shell, etc.	Thick- ness Feet	Depth Feet
(1) Owner of Land: <u>Mrs Ruby Williams</u> (Name) <u>Union, Miss.</u> (Address)	<u>13 ft. clay #8 ft.</u> <u>sand</u>		
(2) Location: <u>35</u> <u>9^N 11^E</u> <u>1/4</u> , <u>1/4</u> , Sec. <u>1</u> <u>R</u> , _____ miles _____ of <u>Union</u> (distance) (direction) (Nearest Town)			
(3) Topography: <u>Hilly</u> (Hilly) (Flat) (Level)			
(4) Purpose of Well: <u>Home use</u> (Domestic Irrigation Municipal, Industrial, Other)			

CODED

Information upon completion of well:

(1) Diameter 4 1/2 inches.

(2) Total Depth 60 feet.

(3) Water Level 42 feet below top of ground.

(4) Cased to 54, Size 3 in.


(5) Screen: Size 1/2, Length 1 ft.

(6) Were any formations sealed against pollution?
_____ yes, _____ no.

If YES depth of formation _____

Why _____

Drillers Remarks: _____

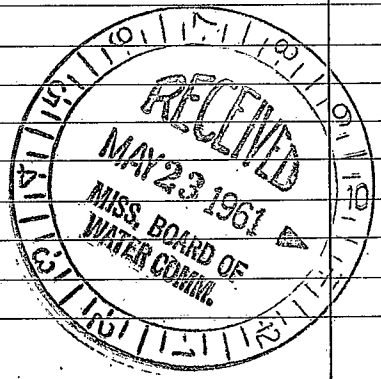

(Use Back Side)

Well No.

