

coded

Deshoba  
Ø 10.  
7-16-69

MISSISSIPPI  
BOARD OF WATER COMMISSIONERS  
416 North State Street  
Jackson, Mississippi 39201

WATER WELL DRILLERS LOG

7-16 1969  
date well completed

RR Nicholson  
firm name

Deshoba  
county well located

LANDOWNER: <u>Thell's Farm</u>	description of formations encountered	depth	
		from	to
<u>Union</u>	<u>1/2" Sand</u>	<u>0</u>	<u>11</u>
<u>Misd</u>	<u>clay dirt</u>	<u>11</u>	<u>65</u>
	<u>water Sand</u>	<u>65</u>	<u>80</u>
(mailing address)			
WELL LOCATION:			
sec. <u>17</u> T. <u>9</u> N. R. <u>11</u> E.			
S W			
<u>7</u> miles <u>North</u> of <u>Union</u>			
(distance) (direction) (nearest town)			
WELL PURPOSE: <u>home</u>			
(home, irrigation, municipal, industrial)			
WELL COMPLETION DATA:			
(1) diameter (inches)	<u>4 1/4</u>		
(2) total depth (feet)	<u>80</u>		
(3) static water level (feet)	<u>40</u>	below	above
		top of	ground.
(4) casing (material)	<u>Galv P</u>	(depth)	<u>75'</u>
	<u>4"</u>	(size)	if telescope see back.
(5) screen (length)	<u>5'</u>	(depth to top)	<u>80</u>
	<u>1/4"</u>	(size)	<u>steel</u>
		(material)	
(6) pump (HP)	<u>1</u>	(yield gpm)	<u>6</u>
	<u>elect</u>	(type power)	
(7) electric log (yes or no)	<u>no</u>		
(organization running log)			
(8) how well bottom plugged	<u>Good</u>		


SEP - 9 1969

MISS. BD. OF WATER COMMISSIONERS

DRILLERS REMARKS:

If well telescopes please sketch and show depths.

GROUND LEVEL

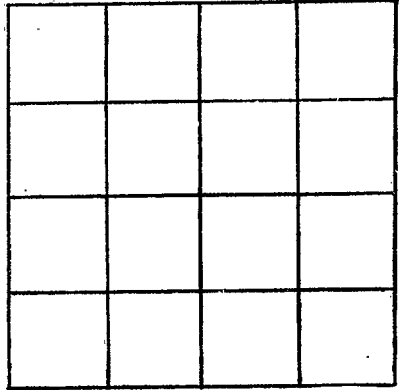

SECTION 17

Please indicate well location X.

ADDITIONAL INFORMATION

If more than one screen, show locations of each on sketch.