

Neshoba  
Ø 12  
9-24-68

MISSISSIPPI  
BOARD OF WATER COMMISSIONERS  
416 North State Street  
Jackson, Mississippi 39201

TETA

WATER WELL DRILLERS LOG

9-24 1968 R B Nicholson Neshoba  
date well completed firm name county well located


LANDOWNER: Joe Rhodes  
Union  
Miss. Rt 1  
(mailing address)

description of formations encountered	from	to
Clay & calc	0'	18'
fin calc + sand	18'	32'
water sand	32'	41'

WELL LOCATION:  
sec. 24 T 9 N R 11 E  
S W  
1/2 miles South of Neshoba  
(distance) (direction) (nearest town)

WELL PURPOSE: Home  
(home, irrigation, municipal, industrial)


- WELL COMPLETION DATA:
- (1) diameter (inches) 4 1/4"
  - (2) total depth (feet) 41'
  - (3) static water level (feet) 24' below top of ground.
  - (4) casing iron pipe 36"  
(material) (depth)  
2"  
(size) if telescope see back.
  - (5) screen 5 ft, 41'  
(length) (depth to top)  
1 1/4, steel  
(size) (material)
  - (6) pump 1 14  
(HP) (yield gpm)  
Electric  
(type power)
  - (7) electric log no  
(yes or no)  
no  
(organization running log)
  - (8) how well bottom plugged Screen

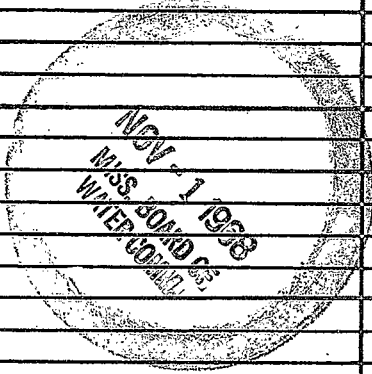

DRILLERS REMARKS:

If well telescopes please sketch and show depths.

GROUND LEVEL

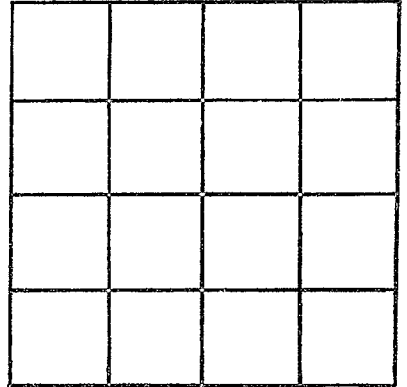

SECTION 24

Please indicate well location X.

ADDITIONAL INFORMATION

If more than one screen,  
show locations of each on sketch.