

Neshoba
014
11-3-69

MISSISSIPPI
 BOARD OF WATER COMMISSIONERS
 416 North State Street
 Jackson, Mississippi 39201

CODED

CODED

WATER WELL DRILLERS LOG

11-3 date well completed 1969 R.R. Nicholson firm name Neshoba county well located


LANDOWNER:	description of formations encountered	from	to
<u>Lewis Driskell</u> <u>Union</u>			
<u>Miss</u> (mailing address)	<u>blue dirt</u>	<u>20</u>	<u>60</u>
	<u>with blue sand</u>	<u>60</u>	<u>72</u>
	<u>water sand</u>	<u>72</u>	<u>83</u>
WELL LOCATION:			
sec. <u>18</u> T. <u>9</u> N R. <u>11</u> E			
S W			
<u>6</u> miles <u>N.W.</u> of <u>Union</u>			
(distance) (direction) (nearest town)			
WELL PURPOSE: <u>home</u>			
(home, irrigation, municipal, industrial)			
WELL COMPLETION DATA:			
(1) diameter (inches)	<u>4 1/4</u>		
(2) total depth (feet)	<u>83</u>		
(3) static water level (feet)	<u>30</u>		below top of ground.
(4) casing (material)	<u>galv. pipe</u>		(depth) <u>83</u>
	<u>2"</u>		(size) If telescope see back.
(5) screen (length)	<u>5</u>		(depth to top) <u>78</u>
	<u>1 1/4"</u>		(size) (material) <u>Steel</u>
(6) pump (HP)	<u>1</u>		(yield gpm) <u>12</u>
	<u>Elect.</u>		(type power)
(7) electric log (yes or no)			
(organization running log)			
(8) how well bottom plugged			
DRILLERS REMARKS:			

JAN 21 1970

MISS. Bd. OF
 WATER COMMISSIONERS

If well telescopes please sketch and show depths.

GROUND LEVEL

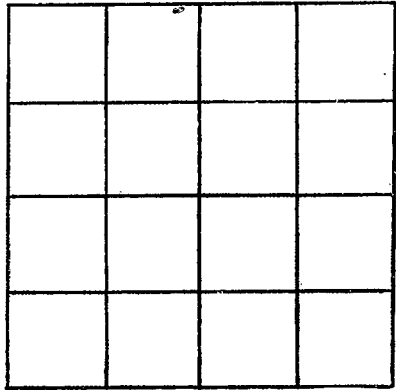

SECTION 18

Please indicate well location X.

ADDITIONAL INFORMATION

If more than one screen, show locations of each on sketch.