

MISSISSIPPI
BOARD OF WATER COMMISSIONERS
416 North State Street
Jackson, Mississippi 39201

COPIED

WATER WELL DRILLERS LOG

Neshoba
Q 15
1-12170

1-12 1970 date well completed
70 of the Drilling firm name
Neshoba county well located

LANDOWNER:

Lee Richardson

description of formations encountered

from to

Rt. 2 Neshoba, Miss.
(mailing address)

Red Clay	0	40
Red sand	40	48
Blue chalk	48	115
White sand	115	142

WELL LOCATION:

sec. 22 T. 9 N. R. 11 E.
S W
2 miles west of Neshoba
(distance) (direction) (nearest town)

WELL PURPOSE: home
(home, irrigation, municipal, industrial)

WELL COMPLETION DATA:


- (1) diameter (inches) 2"
- (2) total depth (feet) 142
- (3) static water level (feet) 80 below top of ground.
- (4) casing Rod. 137
(material) (depth)
If telescope see back.
(size)
- (5) screen 6' 142-137
(length) (depth to top)
1 1/2 stainless steel
(size) (material)
- (6) pump 3/4 5
(HP) (yield gpm)
elec.
(type power)
- (7) electric log no.
(yes or no)
(organization running log)
- (8) how well bottom plugged Paved

JAN 30 1970
MISS. BU. OF WATER COMM.

DRILLERS REMARKS:

If well telescopes please
sketch and show depths.

GROUND LEVEL

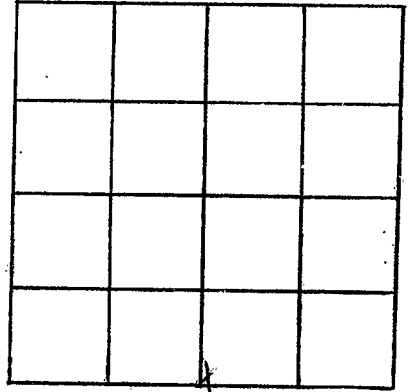

SECTION 22

Please indicate well location X.

ADDITIONAL INFORMATION

If more than one screen,
show locations of each on sketch.