

CODED

MISSISSIPPI
BOARD OF WATER COMMISSIONERS
416 North State Street
Jackson, Mississippi 39201
WATER WELL DRILLERS LOG

NESTROBA
Ø 16
1-27-70

1-29 1970 COMANS DRILLING Nestroba
date well completed firm name county well located

LANDOWNER: Loyd Phillips
Union Mill

description of formations encountered	from	to
Sand clay	0	28
Clay	28	60
Shale Rock	60	80
Clay	80	120
Shale + sand	120	140

(mailing address)

WELL LOCATION:
sec 36 T 9 N R 11 E
1 miles N of UNION
(distance) (direction) (nearest town)

WELL PURPOSE: Home
(home, irrigation, municipal, industrial)

WELL COMPLETION DATA:

- (1) diameter (inches) 2
- (2) total depth (feet) 150
- (3) static water level (feet) 90 below top of ground.
- (4) casing 5" steel, 105' (material), (depth)
- (size) if telescope see back.
- (5) screen 1" (length), (depth to top)
- (size), (material)
- (6) pump 1" (HP), 6 (yield gpm)
- E (type power)
- (7) electric log (yes or no)
- (organization running log)
- (8) how well bottom plugged


FEB 10 1970

DRILLERS REMARKS:
Open Bottom

MISS. BD. OF
WATER COMM.

If well telescopes please sketch and show depths.

GROUND LEVEL

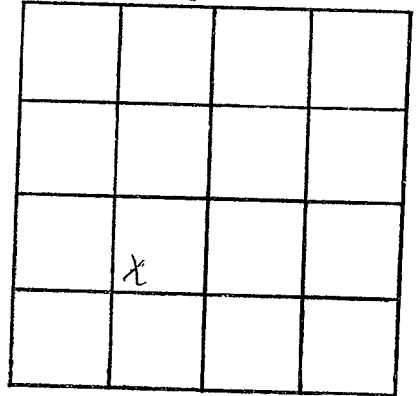

SECTION 36

Please indicate well location X.

ADDITIONAL INFORMATION

If more than one screen, show locations of each on sketch.