

coiled

Neshoba
Ø18
5-18-70

MISSISSIPPI
BOARD OF WATER COMMISSIONERS
416 North State Street
Jackson, Mississippi 39201

WATER WELL DRILLERS LOG

5-18 1970 R B Nicholson Neshoba
date well completed firm name county well located

LANDOWNER: Kenneth Mitchell	description of formations encountered	from	to
Union			
Miss	Chalk & Clay	0	40
(mailing address)	blue dirt	40	130
	blue dirt & sand	130	150
	water sand	150	168

WELL LOCATION:
sec. 16 T 9 N R 11 E
7 1/2 miles north Union
(distance) (direction) (nearest town)

WELL PURPOSE: home
(home, irrigation, municipal, industrial)

- WELL COMPLETION DATA:
- (1) diameter (inches) 4 1/4
 - (2) total depth (feet) 168
 - (3) static water level (feet) 80 below top of ground.
 - (4) casing galv. 163 (material) (depth)
2" if telescope see back. (size)
 - (5) screen 5' 168 (length) (depth to top)
1 1/4" steel (size) (material)
 - (6) pump 1 8 (HP) (yield gpm)
Elect (type power)
 - (7) electric log no (yes or no)
 - (organization running log)
 - (8) how well bottom plugged Screen


JUL 24 1970

DRILLERS REMARKS:

MISS. BD. OF
WATER COMM.

If well telescopes please sketch and show depths.

GROUND LEVEL

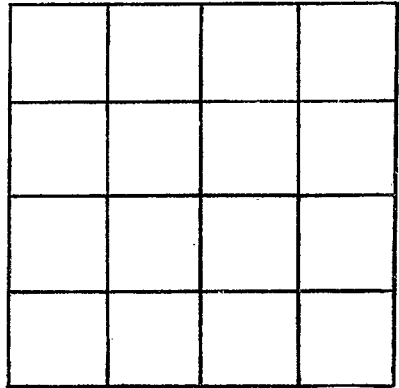

SECTION _____

Please indicate well location X.

ADDITIONAL INFORMATION

If more than one screen, show locations of each on sketch.