

NESHORA

Ø 22

4-29-71

MISSISSIPPI
BOARD OF WATER COMMISSIONERS
416 North State Street
Jackson, Mississippi 39201

CODED

WATER WELL DRILLERS LOG

4-29 1971
date well completed

R.R. Nicholson Neshoba
firm name county well located

LANDOWNER: Willie Buckley
Union
Miss.
(mailing address)

description of formations encountered	from	to
clay	0	20
Chalk & dirt	20	50
Wet Sand Chalk	50	78
Water Sand	78	85

WELL LOCATION:
sec. 29 T 9 N R 11 E
6 miles west of Union
(distance) (direction) (nearest town)

WELL PURPOSE: home
(home, irrigation, municipal, industrial)

- WELL COMPLETION DATA:
- (1) diameter (inches) 4 1/4"
 - (2) total depth (feet) 85
 - (3) static water level (feet) 58 below top of ground.
 - (4) casing Galv. 80' (material) (depth)
2" (size) If telescope see back.
 - (5) screen 5' 85' (length) (depth to top)
1 1/4" steel (size) (material)
 - (6) pump 1 8 (HP) (yield gpm)
Elect. (type power)
 - (7) electric log no (yes or no)

CODED

(organization running log)

(8) how well bottom plugged Screen


DRILLERS REMARKS:

MAY 3 - 1971

MISS. Bd. of
WATER COMMISSIONERS

If well telescopes please sketch, and show depths.

GROUND LEVEL

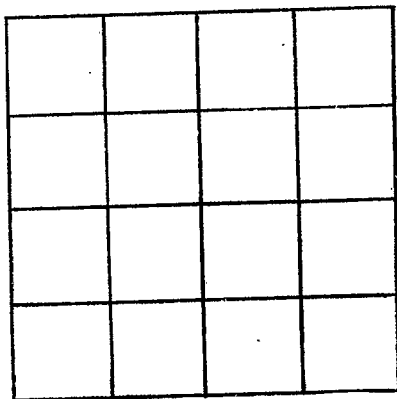

SECTION _____

Please indicate well location X.

ADDITIONAL INFORMATION

If more than one screen, show locations of each on sketch.