

Neshoba

0 25

6-5-71

MISSISSIPPI BOARD OF WATER COMMISSIONERS 416 North State Street Jackson, Mississippi 39201

CODED

WATER WELL DRILLERS LOG

6-5-1971 date well completed

RR Nicholson firm name

Neshoba county well located

LANDOWNER: Nora Hillman

Union

Miss Rt 1 (mailing address)

description of formations encountered

from to

Clay

0 15

Chalk & dirt

15 73

Shell & dirt

73 80

Sand & dirt

80 95

Water Sand

95 106

WELL LOCATION:

sec. 29 T. 9 N R. 11 E 5 1/2 miles West of Union (distance) (direction) (nearest town)

WELL PURPOSE: home (home, irrigation, municipal, industrial)

WELL COMPLETION DATA:

- (1) diameter (inches) 4 1/4"
(2) total depth (feet) 106'
(3) static water level (feet) 90' below top of ground.
(4) casing Gal. 101' (material) (depth) 2" (size) if telescope see back.
(5) screen 5' 106' (length) (depth to top) 1 1/4" (size) steel (material)
(6) pump 1/2 (HP) 4 (yield gpm) Elect (type power)
(7) electric log no (yes or no)

CODED

(organization running log)


(8) how well bottom plugged

DRILLERS REMARKS:

NOV 19 1971

If well telescopes please sketch and show depths.

GROUND LEVEL

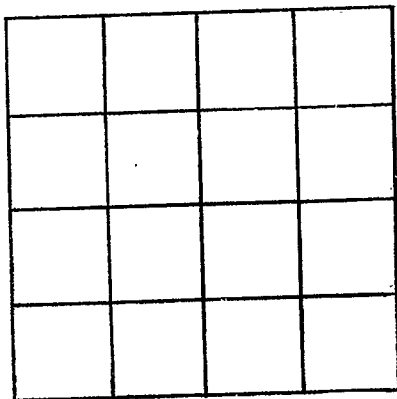

SECTION _____

Please indicate well location X.

ADDITIONAL INFORMATION

If more than one screen, show locations of each on sketch.