

**CODED**

**Neshoba**

026

9-8-71

MISSISSIPPI  
BOARD OF WATER COMMISSIONERS

416 North State Street

Jackson, Mississippi 39201 FEB 18 1972

**WATER WELL DRILLERS LOG**

9-8  
date well completed

1971 Beck Smith  
firm name

Neshoba  
county well located

LANDOWNER: Jerry Jenkins

Phila, Miss

(mailing address)

description of formations encountered

from to

red clay

0 20

blue

20 38

gray sand

38 60

**WELL LOCATION:**

sec. 1 T. 9 N. R. 11 E.  
10 miles SW of Phila  
(distance) (direction) (nearest town)

WELL PURPOSE: home  
(home, irrigation, municipal, industrial)

**WELL COMPLETION DATA:**

- (1) diameter (inches) 2"
- (2) total depth (feet) 60'
- (3) static water level (feet) 35' below above top of ground.
- (4) casing galv, 55'  
(material) (depth)  
2" If telescope see back.  
(size)
- (5) screen 5', 55'  
(length) (depth to top)  
008, stainless steel  
(size) (material)
- (6) pump 1/2 6  
(HP) (yield gpm)  
elec  
(type power)
- (7) electric log NO  
(yes or no)

(organization running log)


(8) how well bottom plugged back  
wash valve

DRILLERS REMARKS:

**CODED**

If well telescopes please sketch and show depths.

GROUND LEVEL

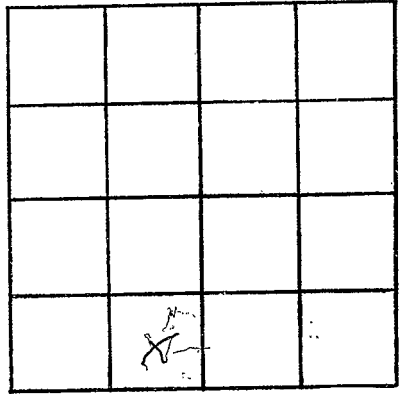

SECTION   L  

Please indicate well location X.

ADDITIONAL INFORMATION

If more than one screen,  
show locations of each on sketch.