

Neshoba
Ø 29
4-21-72

MISSISSIPPI
 BOARD OF WATER COMMISSIONERS
 416 North State Street
 Jackson, Mississippi 39201

CODED

WATER WELL DRILLERS LOG


4-21 1972 R. R. Nicholson Neshoba
 date well completed firm name county well located

LANDOWNER	description of formations encountered	from	to
Jerry Hardin Union, Miss	Clay	0	18
(mailing address)	Mix dirt & Sand	18	38
WELL LOCATION: sec. 34 T. 9 N R. 11 E 5 miles west of Union (distance) (direction) (nearest town)	Shell & Rock	38	52
WELL PURPOSE: Home (home, irrigation, municipal, industrial)	Chalk & Dirt	52	85
WELL COMPLETION DATA:	Water Sand	85	100
(1) diameter (inches) 4 1/4"			
(2) total depth (feet) 100'			
(3) static water level (feet) 80' below top of ground.			
(4) casing (material) 95 (depth)			
4 (size) if telescope see back.			
(5) screen 5 (length) 95 (depth to top)			
1 1/4" (size) (material)			
(6) pump 0 (HP) 0 (yield gpm)			
0 (type power)			
(7) electric log No. (yes or no)			
N/A (organization running log)			
(8) how well bottom plugged			
DRILLERS REMARKS:			

CODED

If well telescopes please sketch and show depths.

GROUND LEVEL

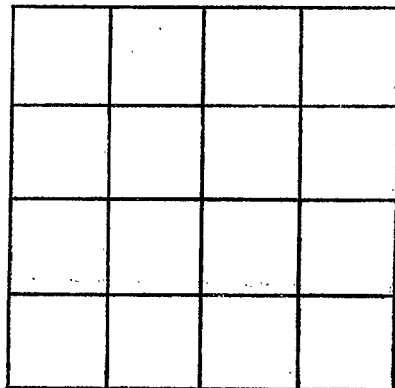

SECTION 5

Please indicate well location X.

ADDITIONAL INFORMATION

Area with horizontal lines for additional information.

If more than one screen, show locations of each on sketch.