

74

Ø 30
NESHOBA
4-10-73

MISSISSIPPI
BOARD OF WATER COMMISSIONERS
416 North State Street
Jackson, Mississippi 39201

CODED

WATER WELL DRILLERS LOG

4-10 1973 *Compass Drilling* *Neshoba*
date well completed firm name county well located

LANDOWNER: *Richard Ridgley*
Union #1
Miss
(mailing address)

description of formations encountered	from	to
<i>Slag</i>	<i>0</i>	<i>60</i>
<i>Sand + Clay</i>	<i>60</i>	<i>110</i>

WELL LOCATION:
sec. *25* T *9* N R *11* E
8 miles *E* of *Subertown*
(distance) (direction) (nearest town)

<i>Sand</i>	<i>110</i>	<i>118</i>
<i>Clay</i>	<i>118</i>	<i>138</i>
<i>Sand</i>	<i>138</i>	<i>160</i>

WELL PURPOSE: *Home*
(home, irrigation, municipal, industrial)

WELL COMPLETION DATA:
(1) diameter (inches) *2"*
(2) total depth (feet) *245*
(3) static water level (feet) *130* below above top of ground.
(4) casing *Steel* *189*
(material) (depth)
(size) If telescope see back.
(5) screen (length) (depth to top)
(size) (material)
(6) pump *1 1/2* *4*
(HP) (yield gpm)
Eubank
(type power)
(7) electric log *MI*
(yes or no)
(organization running log)
(8) how well bottom plugged

<i>Clay</i>	<i>160</i>	<i>202</i>
<i>Rock + Gravel</i>	<i>202</i>	<i>214</i>
<i>Rock + Shell</i>	<i>214</i>	<i>235</i>
<i>Sand</i>	<i>239</i>	<i>245</i>


CODED

DRILLERS REMARKS:
Open Bottom

NOV 20 1973

If well telescopes please sketch and show depths.

GROUND LEVEL

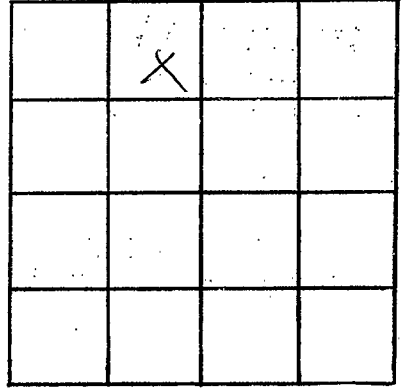

SECTION _____

Please indicate well location X.

ADDITIONAL INFORMATION

If more than one screen, show locations of each on sketch.