

NE3403A

Φ 32

9-19-73

MISSISSIPPI
 BOARD OF WATER COMMISSIONERS
 416 North State Street
 Jackson, Mississippi 39201

WATER WELL DRILLERS LOG

Neshoba

9-19 1973
date well completed

THOMAS + SON
firm name

Neshoba
county well located

LANDOWNER: W. J. Pickney

DIXON, MISS

description of formations encountered

from to

Red Clay + Rock	0	12
yellow Mealy sand	12	40
COARSE SAND	50	66

(mailing address)

WELL LOCATION:

sec. 5 T 9 N R 1 E

2 1/2 miles E of DIXON
(distance) (direction) (nearest town)

WELL PURPOSE:

(home, irrigation, municipal, industrial)

WELL COMPLETION DATA:

- (1) diameter (inches) 2
- (2) total depth (feet) 66
- (3) static water level (feet) 30 (below top of ground)

CODED

(4) casing PVC 61
(material) (depth)

2 (size) If telescope see back.

(5) screen 5 61
(length) (depth to top)

2" 8510 PVC
(size) (material)

(6) pump 3/4 2
(HP) (yield gpm)

Ebe
(type power)

(7) electric log 10
(yes or no)

(organization running log)


(8) how well bottom plugged 100%

DRILLERS REMARKS:

WELL 12 013

If well telescopes please sketch and show depths.

GROUND LEVEL

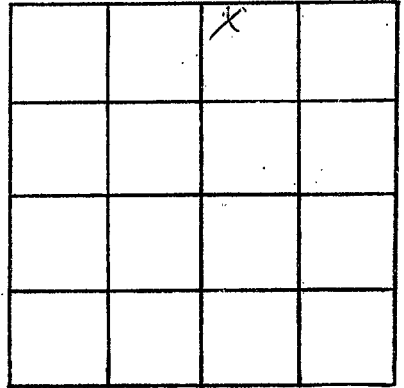

SECTION 5

Please indicate well location X.

ADDITIONAL INFORMATION

If more than one screen,
show locations of each on sketch.