

NE SHUBA

Ø 34

10/10/71

MISSISSIPPI BOARD OF WATER COMMISSIONERS CODED

416 North State Street
Jackson, Mississippi 39201

WATER WELL DRILLERS LOG

10-10-71

Corona Drilling

Merchise

date well completed

firm name

county well located

LANDOWNER: Oliver Hopkins

description of formations encountered	from	to
Clay	0	20
Red Sand	20	40
Clay	40	80
Sand	80	110
Rock + Clay	110	130
Sand	130	140

Oliver RPH

Union
(mailing address)

WELL LOCATION:

sec. 31 T 9 N R 11 E
6 miles N of Union
(distance) (direction) (nearest town)

WELL PURPOSE: Home
(home, irrigation, municipal, industrial)

WELL COMPLETION DATA:

- (1) diameter (inches) 2 1/2
- (2) total depth (feet) 140
- (3) static water level (feet) 45 below top of ground.
- (4) casing Steel 84 (material) (depth)
- (size) If telescope see back.
- (5) screen (length) (depth to top)
- (size) (material)
- (6) pump 1/2 (HP) 5 (yield gpm)
- Electric (type power)
- (7) electric log No (yes or no)
- (organization running log)
- (8) how well bottom plugged

CODED


OCT 20 1974

DRILLERS REMARKS:

MISS. BD. OF WATER COMMISSIONERS

If well telescopes please
sketch and show depths.

GROUND LEVEL

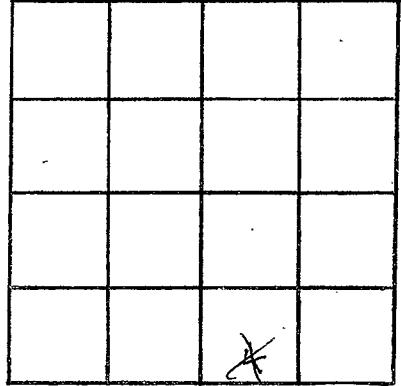

SECTION 31

Please indicate well location X.

ADDITIONAL INFORMATION

If more than one screen,
show locations of each on sketch.