

NE SHOBA

0 2001

2-13-79

MISSISSIPPI BOARD OF WATER COMMISSIONERS 416 North State Street Jackson, Mississippi 39201

WATER WELL DRILLERS LOG

2-13 date well completed

1979 Mc Donald & Hill Inc firm name

ne shoba county well located

LANDOWNER: Ray Comp Jr Rt # 2

description of formations encountered

from

to

sand

0

35

clay

35

40

shale

40

72

sandy st rock

72

98

shale

98

148

sandy st rock

148

160

st green sand

160

180

shale

180

190

st sand

190

200

Union, Miss (mailing address)

WELL LOCATION:

sec 32 T 9 N R 11 E S W

7 1/2 miles west of Union Miss (distance) (direction) (nearest town)

WELL PURPOSE: home (home, irrigation, municipal, industrial)

WELL COMPLETION DATA:

- (1) diameter (inches) 4
(2) total depth (feet) 200
(3) static water level (feet) 55 below above top of ground.
(4) casing 4" 120' (material) (depth)
(size) if telescope see back.
(5) screen no (length) (depth to top)
(size) (material)
(6) pump 1/2 86 GPM (HP) (yield gpm)
(type power)
(7) electric log no (yes or no)
(organization running log)
(8) how well bottom plugged open end

DRILLERS REMARKS: none


Miss. Board of Water Comm.

FEB 20 1979

RECEIVED

If well telescopes please sketch and show depths.

GROUND LEVEL

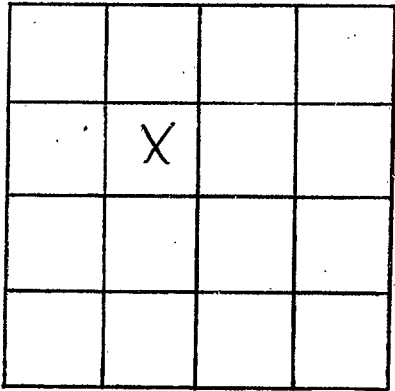

SECTION 32

Please indicate well location X.

ADDITIONAL INFORMATION

A series of horizontal lines for writing additional information, starting below the 'ADDITIONAL INFORMATION' header and extending down to the bottom of the page.

If more than one screen, show locations of each on sketch.