

NE SHOBA

0 2002

04-16-79

MISSISSIPPI BOARD OF WATER COMMISSIONERS
416 North State Street
Jackson, Mississippi 39201

WATER WELL DRILLERS LOG

4-16-79
date well completed

McDonald + Hill
firm name

Neshoba
county well located

LANDOWNER:

Canoy Thomas
Rt 2 Union
(mailing address)

description of formations encountered

from 0 to 20

clay
clay + Rock

90 35

WELL LOCATION:

sec 28 T 9 N R 11 E
2 1/2 miles N of Union
(distance) (direction) (nearest town)

sand + shale 35 80

WELL PURPOSE:

(home, irrigation, municipal, industrial)

WELL COMPLETION DATA:

- (1) diameter (inches) 2"
- (2) total depth (feet) 80'
- (3) static water level (feet) 93' below top of ground.
- (4) casing PVC 75' (material), (depth)
2" (size) if telescope see back.
- (5) screen 3' 75 to 80 (length), (depth to top)
2" PVC (size), (material)
- (6) pump 3 (HP), 49 gpm (yield gpm)
E (type power)

(7) electric log (yes or no)

(organization running log)

(8) how well bottom plugged valve

Miss. Board of Water Comm.


APR 19 1979

DRILLERS REMARKS:

RECEIVED

If well telescopes please sketch and show depths.

GROUND LEVEL

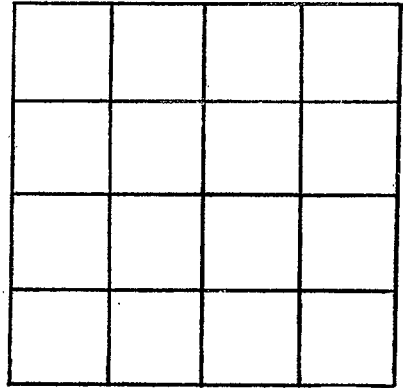

SECTION _____

Please indicate well location X.

ADDITIONAL INFORMATION

If more than one screen,
show locations of each on sketch.