

NE SHOBA
 0 2003
 8/07/79

MISSISSIPPI
 BOARD OF WATER COMMISSIONERS
 416 North State Street
 Jackson, Mississippi 39201

WATER WELL DRILLERS LOG

8-7-79 19 McDonald & Hill New Shoba
 date well completed firm name county well located

LANDOWNER: Ken Morrison
 Rt # 2 Union (mailing address)
 description of formations encountered: clay
 from 0 to 10
 shale 10 to 21

WELL LOCATION: sec 27 T 9 N R 11 E
 6 miles NW of Union
 (distance) (direction) (nearest town)
 description of formations encountered: Rocks & shells 21 to 48
 green sand 48 to 60
 white sand 60 to 95

WELL PURPOSE: (home, irrigation, municipal, industrial)

WELL COMPLETION DATA:
 (1) diameter (inches) 4"
 (2) total depth (feet) 93
 (3) static water level (feet) 18' below top of ground.
 (4) casing PVC 90' (material) (depth)
 4" (size) if telescope see back.
 (5) screen (length) (depth to top)
 (size) (material)
 (6) pump 1/2 69 gpm (HP) (yield gpm)
 E (type power)
 (7) electric log (yes or no)
 (organization running log)
 (8) how well bottom plugged Done

Miss. Board of Water Comm.


AUG 14 1979

RECEIVED

DRILLERS REMARKS:

If well telescopes please sketch and show depths.

GROUND LEVEL

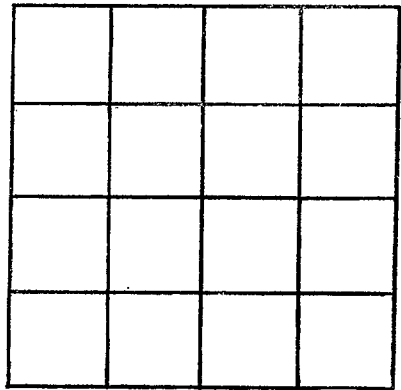

SECTION _____

Please indicate well location X.

ADDITIONAL INFORMATION

If more than one screen, show locations of each on sketch.