

NESHOBA
 2004
 10-23-80

MISSISSIPPI
 BOARD OF WATER COMMISSIONERS
 416 North State Street
 Jackson, Mississippi 39201

5

WATER WELL DRILLERS LOG

10-23-80 date well completed
 Crown Drilling Machine firm name
 county well located

LANDOWNER: She Luvon
Philippa MS
R#5
 (mailing address)


description of formations encountered	from	to
<u>Gravel</u>	0	40

WELL LOCATION:
 sec. 27 T. 9 N. R. 11 E
10 miles E of Silver Lake Sand
 (distance) (direction) (nearest town)

<u>Sandy Clay</u>	0	115
<u>Silver Lake Sand</u>	115	125

WELL PURPOSE: Home
 (home, irrigation, municipal, industrial)


- WELL COMPLETION DATA:
- diameter (inches) 9 1/4
 - total depth (feet) 125
 - static water level (feet) 100 below above top of ground.
 - casing PK 120
 (material) (depth)
 (size) if telescope see back.
 - screen 5 120
 (length) (depth to top)
2 1/2 5 standard 5 ft
 (size) (material)
 - pump 1 1/2 5
 (HP) (yield gpm)
Electric
 (type power)
 - electric log no
 (yes or no)
 (organization running log)
 - how well bottom plugged

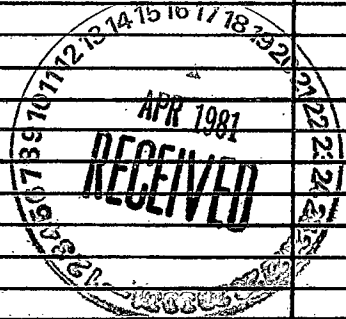

DRILLERS REMARKS:

If well telescopes please sketch and show depths.

GROUND LEVEL

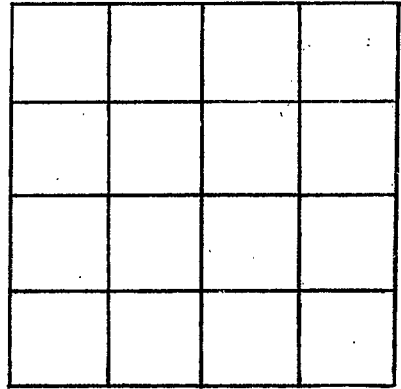

SECTION _____

Please indicate well location X.

ADDITIONAL INFORMATION

If more than one screen,
show locations of each on sketch.