

3 131

Neshoba

P4

4-67

CODED

MISSISSIPPI
 BOARD OF WATER COMMISSIONERS
 416 North State Street
 Jackson, Mississippi 39201

WATER WELL DRILLERS LOG *Neshoba*

APRIL 27 19 67 OGLETREE DRILLING NEWTON
 date well completed firm name county well located

LANDOWNER: CLAY BANKSTON

description of formations encountered

from to

UNION, MISS.

RED CLAY

0 20

(mailing address)

RED SAND

20 50

WELL LOCATION:

sec. 29 T 9 N R 12 E
 S W
 4 miles *N* East of Union
 (distance) (direction) (nearest town)

WHITE SAND

50 72

WELL PURPOSE: HOME AND INDUSTRIAL
(home, irrigation, municipal, industrial)


WELL COMPLETION DATA:

- (1) diameter (inches) 2 1/2
- (2) total depth (feet) 72
- (3) static water level (feet) 45 below top of ground.
- (4) casing *Galv.* 67 (material) (depth)
 if telescope see back.
- (5) screen 5' 67 (length) (depth to top)
 1 1/2 Stainless Steel (size) (material)
- (6) pump 3/4 6 (HP) (yield gpm)
 REA (type power)
- (7) electric log NO (yes or no)
 (organization running log)

CODED

(8) how well bottom plugged
FLUSH VALVE

DRILLERS REMARKS:

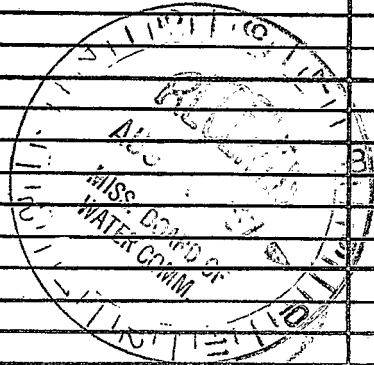

If well telescopes please sketch and show depths.

GROUND LEVEL

			X

SECTION 29

Please indicate well location X.

ADDITIONAL INFORMATION

If more than one screen, show locations of each on sketch.