

213T

Neshoba
P5
9-67

MISSISSIPPI
BOARD OF WATER COMMISSIONERS
CODED 416 North State Street
Jackson, Mississippi 39201

WATER WELL DRILLERS LOG

9-5 19 67 OGLETREE DRILLING NESHOPA
date well completed firm name county well located

LANDOWNER: MILLER EDWARDS

description of formations encountered	from	to
	RED CLAY ROCK	0 12
WHITE SAND	40	63

(mailing address)

WELL LOCATION:

sec. 2 T. 9 (N) R. 12 (E)
S W
7 miles S. of PHILA.
(distance) (direction) (nearest town)

WELL PURPOSE: HOME USE
(home, irrigation, municipal, industrial)

WELL COMPLETION DATA:

- (1) diameter (inches) 2"
- (2) total depth (feet) 63'
- (3) static water level (feet) 50, below above top of ground.
- (4) casing Gav. 58, (material) (depth)

(size) if telescope see back.

- (5) screen 5' 63-58, (length) (depth to top)
1 1/4 STAINLESS STEEL, (size) (material)

CODED

- (6) pump 3/4 5.5, (HP) (yield gpm)


REA (type power)

- (7) electric log (yes or no)

(organization running log)

- (8) how well bottom plugged POINTED

DRILLERS REMARKS:

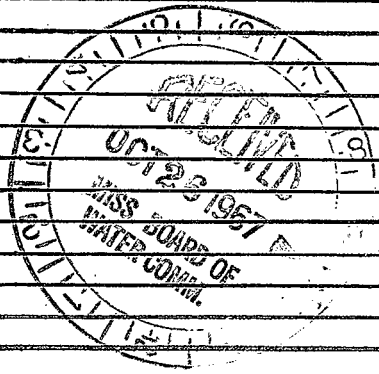

If well telescopes please sketch and show depths.

GROUND LEVEL

	X		

SECTION 2

Please indicate well location X.

ADDITIONAL INFORMATION

If more than one screen, show locations of each on sketch.