

WATER WELL DRILLERS LOG

12-21-60 CODED

Date: 12-21, 1960, Driller: B.R. Nicholaud County: Neeshoba

(Name)

(1) Owner of Land: Carl Adkins (Name)

Union Miss. (Address)

26 9 12

(2) Location: 1/4, 1/4, Sec. T R

1 miles East (distance) (direction) (Nearest Town)

(3) Topography: Hilly (Hilly) (Flat) (Level)

(4) Purpose of Well: domestic (Domestic Irrigation Municipal, Industrial, Other)

Description & Color of Materials Sand, Clay, Red Clay, Shell, etc.

Thick-ness Feet

Depth Feet

dirt	1	6
rock	6	8
colp	8	35
water sand	35	45

Information upon completion of well:

(1) Diameter 4 inches.

(2) Total Depth 45 feet.

(3) Water Level 30 feet below top of ground.

(4) Cased to bottom Size 2"

(5) Screen: Size 1 1/2", Length 6'


(6) Were any formations sealed against pollution?

yes, no.

If YES depth of formation

Why

Drillers Remarks: good well

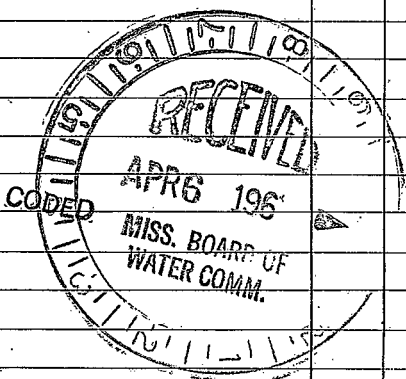

(Use Back Side)

Well No.

