

NESHOPA MISSISSIPPI BOARD OF WATER COMMISSIONERS

P 10

6 13 T

1-30-61 CODED

WATER WELL DRILLERS LOG

Date: 1-30, 1961, Driller: Hester Ogletree County Neshoba (Name)

(1) Owner of Land: W. J. Baker (Name)

Union Rt. (Address) 32912

(2) Location: 1/4, 1/4, Sec. T R

2 miles East of Union (distance) (direction) (Nearest Town)

(3) Topography: Hilly (Hilly) (Flat) (Level)

(4) Purpose of Well: Home use (Domestic Irrigation) (Municipal, Industrial, Other)

Description & Color of Materials Sand, Clay, Red Clay, Shell, etc.

Thick-ness Feet

Depth Feet

40 ft. clay + sand
15.6 ft. blue clay + shell
18 ft. water sand

Information upon completion of well:

(1) Diameter 4 1/2 inches.

(2) Total Depth 214 feet.

(3) Water Level 126 feet below top of ground.

(4) Cased to 208, Size 2 in.

(5) Screen: Size 1 1/2, Length 6 ft.

(6) Were any formations sealed against pollution?


yes, no.

If YES depth of formation 110 ft.

Why

Drillers Remarks: So much iron + minerals

CODED

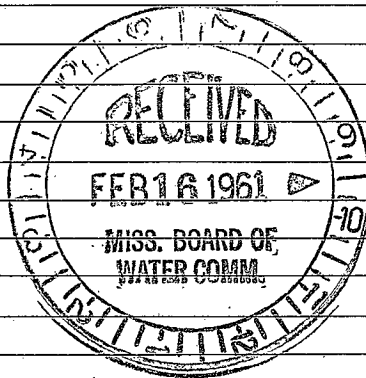

Well No.

(Use Back Side)

