

NESHOBA

WATER WELL DRILLERS LOG

Date: 8-6-64, 1964, Driller: Bob Wilkinson County Neshoba (Name)


(1) Owner of Land: George Hemington (Name) Union, Miss (Address) 2912 (2) Location: 1/4, 1/4, Sec. T. R. 25 miles N.W. of Neshoba (distance) (direction) (Nearest Town) (3) Topography: Hilly (Hilly) (Flat) (Level) (4) Purpose of Well: Domestic (Domestic Irrigation Municipal, Industrial, Other)

Table with 3 columns: Description & Color of Materials, Thickness Feet, Depth Feet. Row 1: Blue clay, 62, 1-62. Row 2: gray sand, 15, 62-77.

Information upon completion of well:

(1) Diameter 2 inches. (2) Total Depth 77 feet. (3) Water Level 35 feet below top of ground. (4) Cased to 67, Size 2 inches. (5) Screen: Size 2", Length 4". (6) Were any formations sealed against pollution? yes, no.

CODED

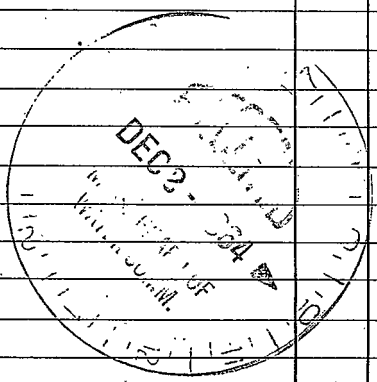

If YES depth of formation Why Drillers Remarks:

Well No.

(Use Back Side)

