

NESTHOBA
P15
10-23-68

MISSISSIPPI
 BOARD OF WATER COMMISSIONERS
 416 North State Street
 Jackson, Mississippi 39201

WATER WELL DRILLERS LOG

10-23 1968 R. B. Nicholson Neshoba
 date well completed firm name county well located

LANDOWNER: Mrs S B Osborne


description of formations encountered	from	to
<u>Clay</u>	<u>0</u>	<u>25-</u>
<u>blue dirt</u>	<u>25-</u>	<u>130-</u>
<u>Sand & water</u>	<u>130</u>	<u>147-</u>
<u>Shell & blue dirt</u>	<u>147</u>	<u>168-</u>
<u>rock & blue dirt</u>	<u>168</u>	<u>231-</u>
<u>blue dirt</u>	<u>231</u>	<u>310-</u>
<u>water sand</u>	<u>310</u>	<u>355-</u>

Union
Miss. Rt 1
 (mailing address)

WELL LOCATION:
 sec 23 T 9 N R 12 E
23 miles of 23 miles of 23 miles
 (distance) (direction) (nearest town)

WELL PURPOSE: home
(home, irrigation, municipal, industrial)


- WELL COMPLETION DATA:
- (1) diameter (inches) 4 1/4"
 - (2) total depth (feet) 355
 - (3) static water level (feet) 190 below above top of ground.
 - (4) casing iron pipe 24" (material) (depth)
 - 2" (size) If telescope see back.
 - (5) screen 10 (length) 355 (depth to top)
1 1/4" (size) Steel (material)
 - (6) pump 3/4 (HP) 4 (yield gpm)
Electric (type power)
 - (7) electric log no (yes or no)
no (organization running log)
 - (8) how well bottom plugged Screen

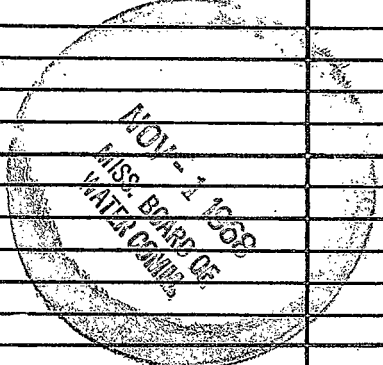

DRILLERS REMARKS:

If well telescopes please sketch and show depths.

GROUND LEVEL

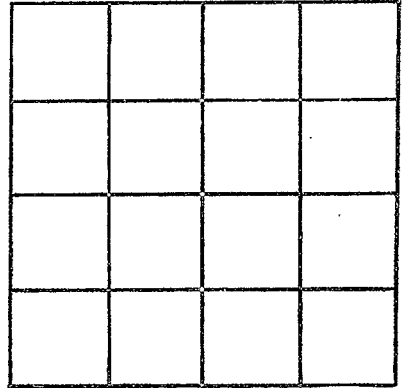

SECTION _____

Please indicate well location X.

ADDITIONAL INFORMATION

If more than one screen, show locations of each on sketch.