

4

13P

325740N 0890120

CODED

TEHA

Neshoba
P16
5-1-68

MISSISSIPPI  
 BOARD OF WATER COMMISSIONERS  
 416 North State Street  
 Jackson, Mississippi 39201

WATER WELL DRILLERS LOG

5-1 1968 RR Nicholson Neshoba  
 date well completed firm name county well located

LANDOWNER: Hugh Jenkins  
Union  
Miss.  
 (mailing address)

description of formations encountered	from	to
	<u>Clay</u>	<u>0</u>
<u>msst</u>	<u>18</u>	<u>23</u>
<u>water sand</u>	<u>23</u>	<u>28</u>


WELL LOCATION:  
 sec 13 T 9 N R 12 E  
 S W  
 (distance) miles (direction) of (nearest town)

WELL PURPOSE:  
 (home, irrigation, municipal, industrial)

WELL COMPLETION DATA:


- (1) diameter (inches) 4 1/2"
- (2) total depth (feet) 28'
- (3) static water level (feet) 22' below top of ground.
- (4) casing bas. 23'  
 (material) (depth)  
2" if telescope see back.  
 (size)
- (5) screen 5' 23'  
 (length) (depth to top)  
1 1/4" Steel  
 (size) (material)
- (6) pump 1/2 4  
 (HP) (yield gpm)  
Electric  
 (type power)
- (7) electric log no  
 (yes or no)  
 (organization running log)
- (8) how well bottom plugged Screen

DRILLERS REMARKS:

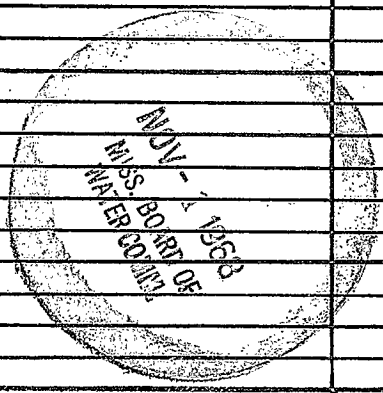

If well telescopes please sketch and show depths.

GROUND LEVEL

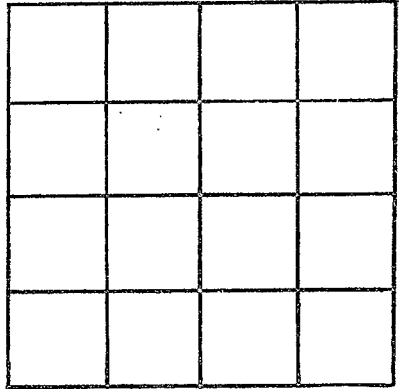

SECTION 13

Please indicate well location X.

ADDITIONAL INFORMATION

If more than one screen, show locations of each on sketch.