

4 13P

32 34 40 N 089 04 90

CODED

TE MW

MISSISSIPPI
 BOARD OF WATER COMMISSIONERS
 416 North State Street
 Jackson, Mississippi 39201

Neshoba
P17
6-18-68

WATER WELL DRILLERS LOG

6-18 1968 RR Nicholson Neshoba
 date well completed firm name county well located

LANDOWNER: Lewis Peruse

description of formations encountered

from to

Union
Miss.
 (mailing address)

<u>Clay sand</u>	<u>0'</u>	<u>40'</u>
<u>blue dirt</u>	<u>40'</u>	<u>120'</u>
<u>rock</u>	<u>120'</u>	<u>125'</u>
<u>blue dirt</u>	<u>125'</u>	<u>205'</u>
<u>mix dirt/sand</u>	<u>205'</u>	<u>240'</u>
<u>water sand</u>	<u>240'</u>	<u>267'</u>

WELL LOCATION:

sec. 32 T 9 N R 12 E
2 miles East of Union
 (distance) (direction) (nearest town)

WELL PURPOSE: home
 (home, irrigation, municipal, industrial)

WELL COMPLETION DATA:

- (1) diameter (inches) 4 1/2"
- (2) total depth (feet) 267'
- (3) static water level (feet) 220' below above top of ground.
- (4) casing 2" 257'
 (material) (depth)

If telescope see back.

- (5) screen 10' 257'
 (length) (depth to top)

1/4" Brass
 (size) (material)

- (6) pump 3/4 5
 (HP) (yield gpm)


electric
(type power)

- (7) electric log NO
 (yes or no)

(organization running log)


- (8) how well bottom plugged Screen

DRILLERS REMARKS:

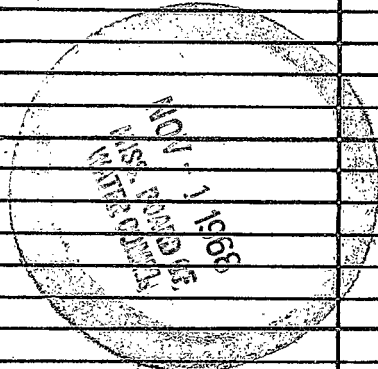

If well telescopes please sketch and show depths.

GROUND LEVEL

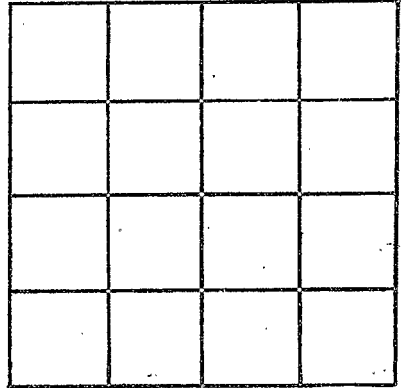

SECTION 32

Please indicate well location X.

ADDITIONAL INFORMATION

If more than one screen, show locations of each on sketch.