

CODED

TETU

Neshoba  
P 18  
7-30-68

MISSISSIPPI  
 BOARD OF WATER COMMISSIONERS  
 416 North State Street  
 Jackson, Mississippi 39201

WATER WELL DRILLERS LOG

7-30 1968 RR Nicholson Neshoba  
 date well completed firm name county well located

LANDOWNER: JH Patterson  
Union Miss

description of formations encountered	from	to
<u>Clay &amp; calc</u>	<u>0'</u>	<u>20'</u>
<u>med clay &amp; calc</u>	<u>20'</u>	<u>50'</u>
<u>blue dirt</u>	<u>50'</u>	<u>140'</u>
<u>Shell &amp; rock</u>	<u>140'</u>	<u>168'</u>
<u>blue dirt</u>	<u>168'</u>	<u>260'</u>
<u>rock</u>	<u>260'</u>	<u>265'</u>
<u>blue dirt</u>	<u>265'</u>	<u>310'</u>
<u>water sand</u>	<u>310'</u>	<u>330'</u>

(mailing address)


WELL LOCATION:  
 sec. 24 T 9 N R 12 E  
                   S                  W  
6 Mi. miles East of Union  
 (distance) (direction) (nearest town)

WELL PURPOSE:  
 (home, irrigation, municipal, industrial)

WELL COMPLETION DATA:


- (1) diameter (inches) 4 1/4"
- (2) total depth (feet) 330'
- (3) static water level (feet) 200 below above top of ground.
- (4) casing hard pipe 2 1/2" 315'  
 (material) (depth)  
2"  
 (size) if telescope see back.
- (5) screen 15' 330'  
 (length) (depth to top)  
1 1/4" Stainless Steel  
 (size) (material)
- (6) pump 1/2 HP 5  
 (HP) (yield gpm)  
Electric  
 (type power)
- (7) electric log no  
 (yes or no)  
 (organization running log)
- (8) how well bottom plugged Screen

DRILLERS REMARKS:

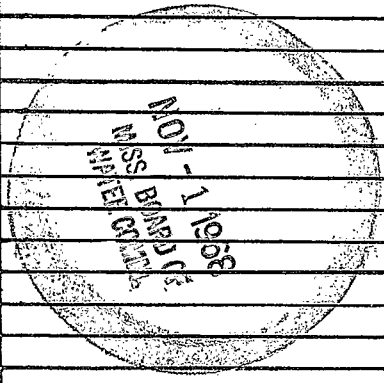

If well telescopes please sketch and show depths.

GROUND LEVEL

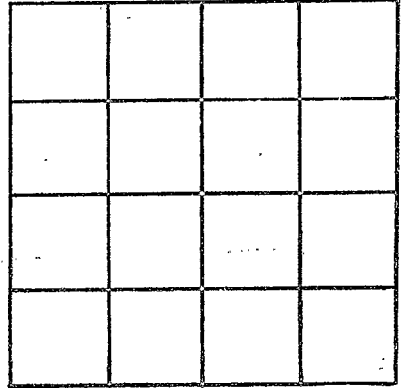

SECTION 24

Please indicate well location X.

ADDITIONAL INFORMATION

If more than one screen, show locations of each on sketch.