

Neshoba
P 19
9-25-68

MISSISSIPPI
BOARD OF WATER COMMISSIONERS
416 North State Street
Jackson, Mississippi 39201

CODED

WATER WELL DRILLERS LOG

Neshoba
Mississippi

9-25-68 date well completed
1968 *Compass Drilling* firm name
county well located

LANDOWNER: *Earl Turrell*

description of formations encountered from to

Union Rth 5
Main
(mailing address)

Sand & Clay 0 32

Rock 32 32 1/2

WELL LOCATION:
sec *21* T *9* N R *12* E
S W
3 miles *NE* of *Union*
(distance) (direction) (nearest town)

Dark Clay 32 1/2 58

Sand 58 102

WELL PURPOSE: *Home*
(home, irrigation, municipal, industrial)

WELL COMPLETION DATA:

(1) diameter (inches) *2"*

(2) total depth (feet) *103*

(3) static water level (feet) *40* below above top of ground.

(4) casing *Steel, 9 1/2*,
(material) (depth)

CODED

if telescope see back.
(size)

(5) screen *6*, *9 1/2*
(length) (depth to top)

1 1/4, *5 1/2*
(size) (material)

(6) pump *Red Pump* *250*
(HP) (yield gpm)

(type power)

(7) electric log *X*
(yes or no)

(organization running log)

(8) how well bottom plugged *B. Wash*


FEB 12 1969

DRILLERS REMARKS:

MISS. Bd. of
WATER COMMISSIONERS

If well telescopes please sketch and show depths.

GROUND LEVEL

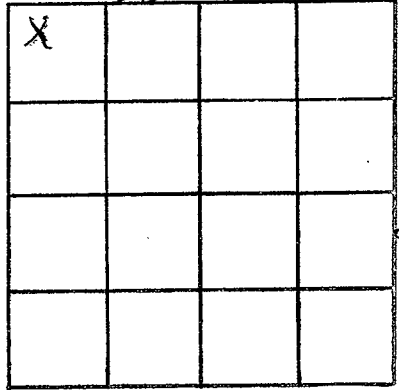

SECTION 21

Please indicate well location X.

ADDITIONAL INFORMATION

If more than one screen, show locations of each on sketch.