

Neshoba
P 20
6-19-69

MISSISSIPPI
 BOARD OF WATER COMMISSIONERS
 416 North State Street
 Jackson, Mississippi 39201

WATER WELL DRILLERS LOG

6-19-1969 date well completed Williamson Drilling Co. firm name Neshoba CODED county well located

LANDOWNER: J. D. Smith
pt 4
Union, Miss.
 (mailing address)

description of formations encountered	from	to
	<u>red clay</u>	<u>0</u>
<u>blue clay</u>	<u>5</u>	<u>20</u>
<u>white sand</u>	<u>20</u>	<u>40</u>
<u>blue clay</u>	<u>40</u>	<u>65</u>
<u>white sand</u>	<u>65</u>	<u>87</u>

WELL LOCATION:
 sec. 9 T. 90 N. R. 12 E.
6 miles NE of Union
 (distance) (direction) (nearest town)

WELL PURPOSE: domestic
 (home, irrigation, municipal, industrial)


- WELL COMPLETION DATA:
- (1) diameter (inches) 2
 - (2) total depth (feet) 87
 - (3) static water level (feet) 52 below above top of ground.
 - (4) casing galv. 81
 (material) (depth)
2 if telescope see back.
 (size)
 - (5) screen 6 81
 (length) (depth to top)
12 stainless
 (size) (material)
 - (6) pump 1/2 red 14
 (HP) (yield gpm)
Elect
 (type power)
 - (7) electric log no
 (yes or no)
no
 (organization running log)
 - (8) how well bottom plugged. Cap

DRILLERS REMARKS:

JUL 15 1969
 MISSISSIPPI
 WATER COMMISSIONERS

If well telescopes please sketch and show depths.

GROUND LEVEL

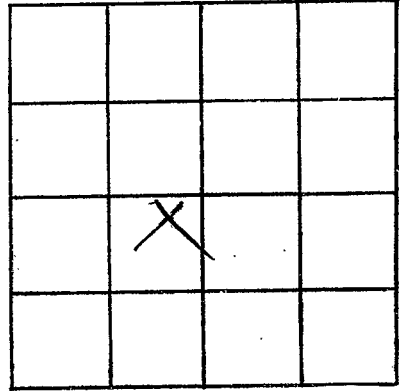

SECTION 9

Please indicate well location X.

ADDITIONAL INFORMATION

If more than one screen,
show locations of each on sketch.