

NESHOPA
P23
7-22-72

MISSISSIPPI
BOARD OF WATER COMMISSIONERS
416 North State Street
Jackson, Mississippi 39201

CODED

WATER WELL DRILLERS LOG

7-22-72 1972 BECK SMITH NESHOPA
date well completed firm name county well located

LANDOWNER: LACY SPEAR
ROUTE
PHILA-MISS
(mailing address)

Description of formations encountered	from	to
RED CLAY	0	75
blue Chalk	75	150
Grey SAND	150	190

WELL LOCATION:
sec. 9 T. 9 N. R. 12 E
S W
9 miles S of PHILA
(distance) (direction) (nearest town)

WELL PURPOSE: HOME
(home, irrigation, municipal, industrial)

- WELL COMPLETION DATA:
- (1) diameter (inches) 2"
 - (2) total depth (feet) 190
 - (3) static water level (feet) 80' ^{below} _{above} top of ground.
 - (4) casing galv. 105'
(material) (depth)
(size) if telescope see back.
 - (5) screen OPEN
(length) (depth to top)
(size) (material)
 - (6) pump LHP
(HP) (yield gpm)
ELC
(type power)
 - (7) electric log _____
(yes or no)
(organization running log)
 - (8) how well bottom plugged _____

CODED


SEP 18 1972
SHEW

MISS. BO. OF
WATER COMMISSIONERS

DRILLERS REMARKS:

If well telescopes please sketch and show depths.

GROUND LEVEL

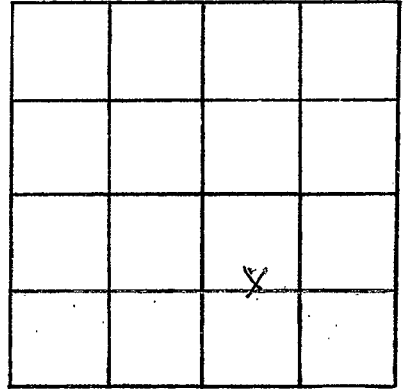

SECTION 3

Please indicate well location X.

ADDITIONAL INFORMATION

If more than one screen, show locations of each on sketch.