

NESHOBA

P 24

3-5-74

MISSISSIPPI BOARD OF WATER COMMISSIONERS
416 North State Street
Jackson, Mississippi 39201

CODED

WATER WELL DRILLERS LOG

3-5

date well completed

74 Ogletree Drilling Co

firm name

Neshoba

county well located

LANDOWNER: S.J. & Deon

description of formations encountered

from to

Ret #3

Union main
(mailing address)

Clay	0	18
muschel	18	24
soil	24	39
water soil	39	49

WELL LOCATION:

sec. 34 T 9 N R 12 E

0 miles EAST of Union
(distance) (direction) (nearest town)

WELL PURPOSE:

(home/irrigation, municipal, industrial)

WELL COMPLETION DATA:

CODED

- (1) diameter (inches) 2
- (2) total depth (feet) 48
- (3) static water level (feet) 35 below top of ground.
- (4) casing 5" Jolt, 42' (material) (depth)

(size) If telescope see back.

(5) screen 6' (length) (depth to top)

1 1/4" Johnson S.S. (size) (material)

(6) pump 3/4 (HP) 8 (yield gpm)

PEA (type power)

(7) electric log (yes or no)

(organization running log)

(8) how well bottom plugged


DRILLERS REMARKS:

RECEIVED
MAR 27 1974

MISS. BD. OF WATER COMM.

If well telescopes please sketch and show depths.

GROUND LEVEL

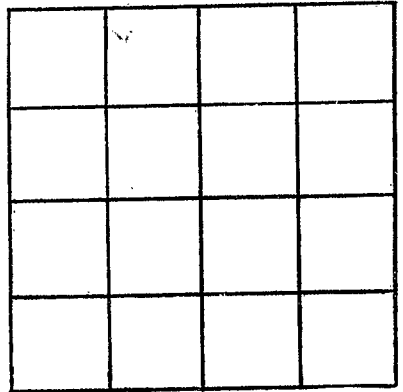

SECTION _____

Please indicate well location X.

ADDITIONAL INFORMATION

If more than one screen,
show locations of each on sketch.