

Neshoba
Paco
3-29-79

MISSISSIPPI
BOARD OF WATER COMMISSIONERS
416 North State Street
Jackson, Mississippi 39201

WATER WELL DRILLERS LOG

3-29-79 date well completed
Williamson Drilling Co firm name
Neshoba county well located

LANDOWNER: J. A. Porcup
RT4
Union, Miss.
(mailing address)

description of formations encountered	from	to
red clay	0	7
shale	7	40
Blue clay	40	85
sand	85	108

WELL LOCATION:
sec. 25 T 90 N R 12 E
4 miles SW of Hound
(distance) (direction) (nearest town)

WELL PURPOSE: Home
(home, irrigation, municipal, industrial)

- WELL COMPLETION DATA:
- (1) diameter (inches) 2
 - (2) total depth (feet) 108
 - (3) static water level (feet) 85 ^{below} top of ground.
 - (4) casing PVC, 103, (material) (depth)
2 (size) if telescope see back.
 - (5) screen 5, 103, (length) (depth to top)
16, PVC, (size) (material)
 - (6) pump 1, 5, (HP) (yield gpm)
Electric (type power)
 - (7) electric log no (yes or no)
no (organization running log)
 - (8) how well bottom plugged cap

Miss. Board of Water Comm.


APR 4 - 1979

RECEIVED

DRILLERS REMARKS:

If well telescopes please sketch and show depths.

GROUND LEVEL

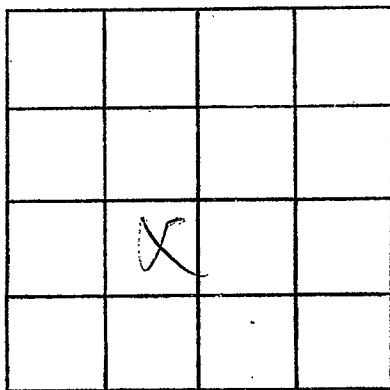

SECTION 25

Please indicate well location X.

ADDITIONAL INFORMATION

If more than one screen, show locations of each on sketch.