

MISSISSIPPI DEPARTMENT OF NATURAL RESOURCES

Bureau of Land and Water Resources

Southport Mall

P.O. Box 10631

Jackson, Mississippi 39209

WATER WELL DRILLERS LOG

Neshoba  
P2001

7-13-82 19 McDonald & Well Neshoba  
date well completed firm name county well located

LANDOWNER:	description of formations encountered	from	to
<u>Henry Smith</u>			
<u>PT # 5 Union</u> (mailing address)	<u>shale</u>	<u>90</u>	<u>60</u>
WELL LOCATION:	<u>clay &amp; sand</u>	<u>60</u>	<u>80</u>
sec <u>25</u> T <u>9</u> N R <u>12</u> E	<u>sand of clay shale</u>	<u>80</u>	<u>115</u>
<u>3</u> miles <u>SW</u> of <u>House</u>			
(distance) (direction) (nearest town)			
WELL PURPOSE: <u>home</u> (home, irrigation, municipal, industrial)			
WELL COMPLETION DATA:			
(1) diameter (inches) <u>9"</u>			
(2) total depth (feet) <u>108'</u>			
(3) static water level (feet) <u>76'</u> below above top of ground.			
(4) casing <u>PVC</u> , <u>98'</u> (material) (depth)			
<u>2"</u> (size) if telescope see back.			
(5) screen <u>10</u> , <u>98 to 108'</u> (length) (depth to top)			
<u>2"</u> <u>PVC</u> (size) (material)			
(6) pump <u>3/4</u> <u>4000</u> (HP) (yield gpm)			
(type power)			
(7) electric log <u>—</u> (yes or no)			
(organization running log)			
(8) how well bottom plugged <u>value</u>			
DRILLERS REMARKS:			


DEPT. OF NATURAL RESOURCES  
BUREAU OF LAND & WATER RESOURCES

JUL 19 1982

RECEIVED

If well telescopes please sketch and show depths.

GROUND LEVEL

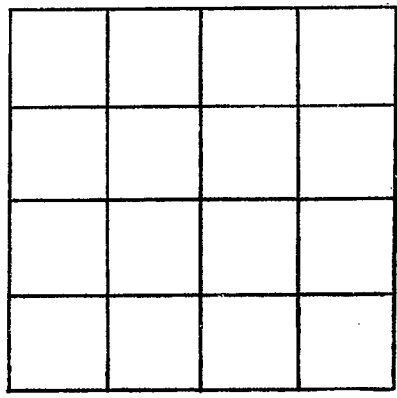

SECTION \_\_\_\_\_

Please indicate well location X.

ADDITIONAL INFORMATION

A series of horizontal lines for writing additional information.

If more than one screen, show locations of each on sketch.