

MISSISSIPPI
BOARD OF WATER COMMISSIONERS

416 North State Street
Jackson, Mississippi 39201

WATER WELL DRILLERS LOG

NESHOBBA
10-5-81

NESHOBBA
Newton

10-5
date well completed

1981 Thomas
firm name

county well located

<p>LANDOWNER: <u>Gerald Russel</u> <u>UNION, MS.</u> (mailing address)</p>	<p>description of formations encountered</p> <table border="1"> <thead> <tr> <th></th> <th>from</th> <th>to</th> </tr> </thead> <tbody> <tr> <td><u>Red CLAY</u></td> <td><u>0</u></td> <td><u>10</u></td> </tr> <tr> <td><u>Red SAND</u></td> <td><u>10</u></td> <td><u>32</u></td> </tr> <tr> <td><u>COURSE SAND.</u></td> <td><u>32</u></td> <td><u>62</u></td> </tr> </tbody> </table>		from	to	<u>Red CLAY</u>	<u>0</u>	<u>10</u>	<u>Red SAND</u>	<u>10</u>	<u>32</u>	<u>COURSE SAND.</u>	<u>32</u>	<u>62</u>
	from	to											
<u>Red CLAY</u>	<u>0</u>	<u>10</u>											
<u>Red SAND</u>	<u>10</u>	<u>32</u>											
<u>COURSE SAND.</u>	<u>32</u>	<u>62</u>											
<p>WELL LOCATION: sec. <u>33</u> T <u>9</u> N R <u>12</u> E S W <u>3</u> miles <u>E</u> of <u>UNION</u> (distance) (direction) (nearest town)</p>													
<p>WELL PURPOSE: (home, irrigation, municipal, industrial)</p>													
<p>WELL COMPLETION DATA:</p> <p>(1) diameter (inches) <u>2</u></p> <p>(2) total depth (feet) <u>62</u></p> <p>(3) static water level (feet) <u>20</u> <u>below</u> top of ground. above</p> <p>(4) casing <u>PVC</u> <u>57</u>, (material) (depth) <u>2</u> if telescope see back. (size)</p> <p>(5) screen <u>5</u> <u>57</u> (length) (depth to top) <u>2 1/2</u> <u>10510 PVC</u> (size) (material)</p> <p>(6) pump <u>1</u> <u>10</u> (HP) (yield gpm) <u>Elec</u> (type power)</p> <p>(7) electric log <u>NO</u> (yes or no)</p> <p>(organization running log)</p> <p>(8) how well bottom plugged <u>POINT</u></p>													


DRILLERS REMARKS:

DEPT. OF NATURAL RESOURCES
BUREAU OF LAND & WATER RESOURCES

RECEIVED
OCT-9 1981

If well telescopes please sketch and show depths.

GROUND LEVEL

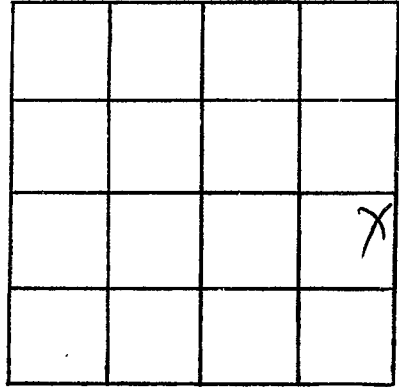

SECTION 33

Please indicate well location X.

ADDITIONAL INFORMATION

A series of horizontal lines for writing additional information, starting below the 'ADDITIONAL INFORMATION' header and extending down to the bottom of the page.

If more than one screen, show locations of each on sketch.