

3 13P

MISSISSIPPI
BOARD OF WATER COMMISSIONERS
416 North State Street
Jackson, Mississippi 39201

WATER WELL DRILLERS LOG

Neshoba
 ① CODED
 1-68

1-4 19 68 OGLETREE DRILLING NESHOPA
 date well completed firm name county well located

LANDOWNER: FRANK FANCHER
 RT. 3 UNION

description of formations encountered

from to

RED

RED CLAY

0 25

RED SAND

25 40

(mailing address)

WHITE SAND

40 68

WELL LOCATION:

sec. 17 T. 9 N R. 13 E
 6 miles SOUTH of PHILA.
 (distance) (direction) (nearest town)

WELL PURPOSE: HOME USE
 (home, irrigation, municipal, industrial)

WELL COMPLETION DATA:

- (1) diameter (inches) 2 1/2
- (2) total depth (feet) 68
- (3) static water level (feet) 30 below above top of ground.
- (4) casing GAV (material), 63 (depth),
 (size) if telescope see back.
- (5) screen 5 ft. (length), 68-63 (depth to top)
 1 1/2 (size), 5 ft. (material)
- (6) pump 3/4 (HP), 6-5 (yield gpm)

CODED


REA
 (type power)

(7) electric log (yes or no)

(organization running log)


(8) how well bottom plugged POINTEE

DRILLERS REMARKS:

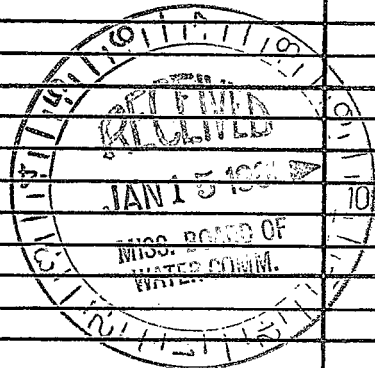

If well telescopes please sketch and show depths.

GROUND LEVEL

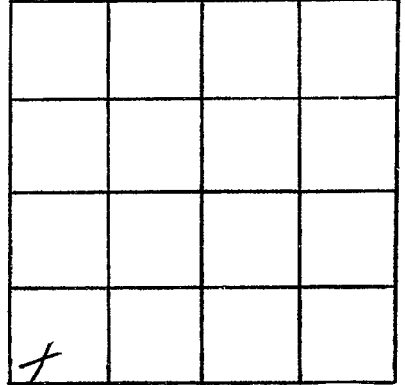

SECTION 17

Please indicate well location X.

ADDITIONAL INFORMATION

If more than one screen, show locations of each on sketch.